

Job
RMA/2021/1941

Title
WASTEWATER ASBUILTS

A	02/23	Preliminary Issue	CP
issue	date	reason	approved

Disclaimer: This document shall only be reproduced in full with approval from Suburban Estates contractor to locate all existing services & verify all dimensions before commencing work

Origin of Levels BM0148, EKRR, RL22.816
Level Datum Mean sea level/Lyttelton vertical datum 1937

Projection - New Zealand Geodetic 2000
Circuit - Mount Pleasant

Design	CP
Drawn	CP
Date	01/23
QA check	CP




Phone: 03 3663729, Fax: 03 3654323 Web: www.suburbanestates.co.nz
26 Peterborough Street, Central PO Box 13 349, Christchurch 8141 New Zealand

AutoCAD ref: ASBUILTS
Sheet 1 of 1

Scale @ A3 1:1000
Scale @ A1 1:500

Drawing **301** Revision **A**

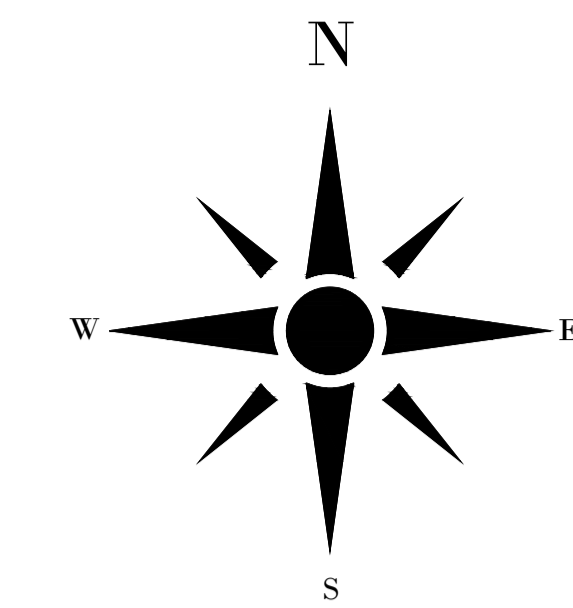

Job
RMA/2021/1941

Title
STORMWATER ASBUILTS

A	02/23	Preliminary Issue	CP
issue	date	reason	approved

Disclaimer: This document shall only be reproduced in full with approval from Suburban Estates contractor to locate all existing services & verify all dimensions before commencing work

Origin of Levels BM0148, EKRR, RL22.816

Level Datum Mean sea level/Lyttelton vertical datum 1937

Projection - New Zealand Geodetic 2000
Circuit - Mount Pleasant

Design	CP
Drawn	CP
Date	01/23
QA check	CP



Phone: 03 3663729, Fax: 03 3654323 Web: www.suburbanestates.co.nz
26 Peterborough Street, Central PO Box 13 349, Christchurch 8141 New Zealand

AutoCAD ref: ASBUILTS
Sheet 1 of 1

Scale @ A3 1:1000
Scale @ A1 1:500
Drawing **302** Revision **A**

