

/ issue	/ date	/ reason	/ approved
A1	19/09/23	224 - As-builts	


AS BUILT



CAD ref: 39630.DwgSet2.Sewer & Stormwater.dwg

/ issue	/ date	/ reason	/ approved
A1	19/09/23	224 - As-builts	

AS BUILT

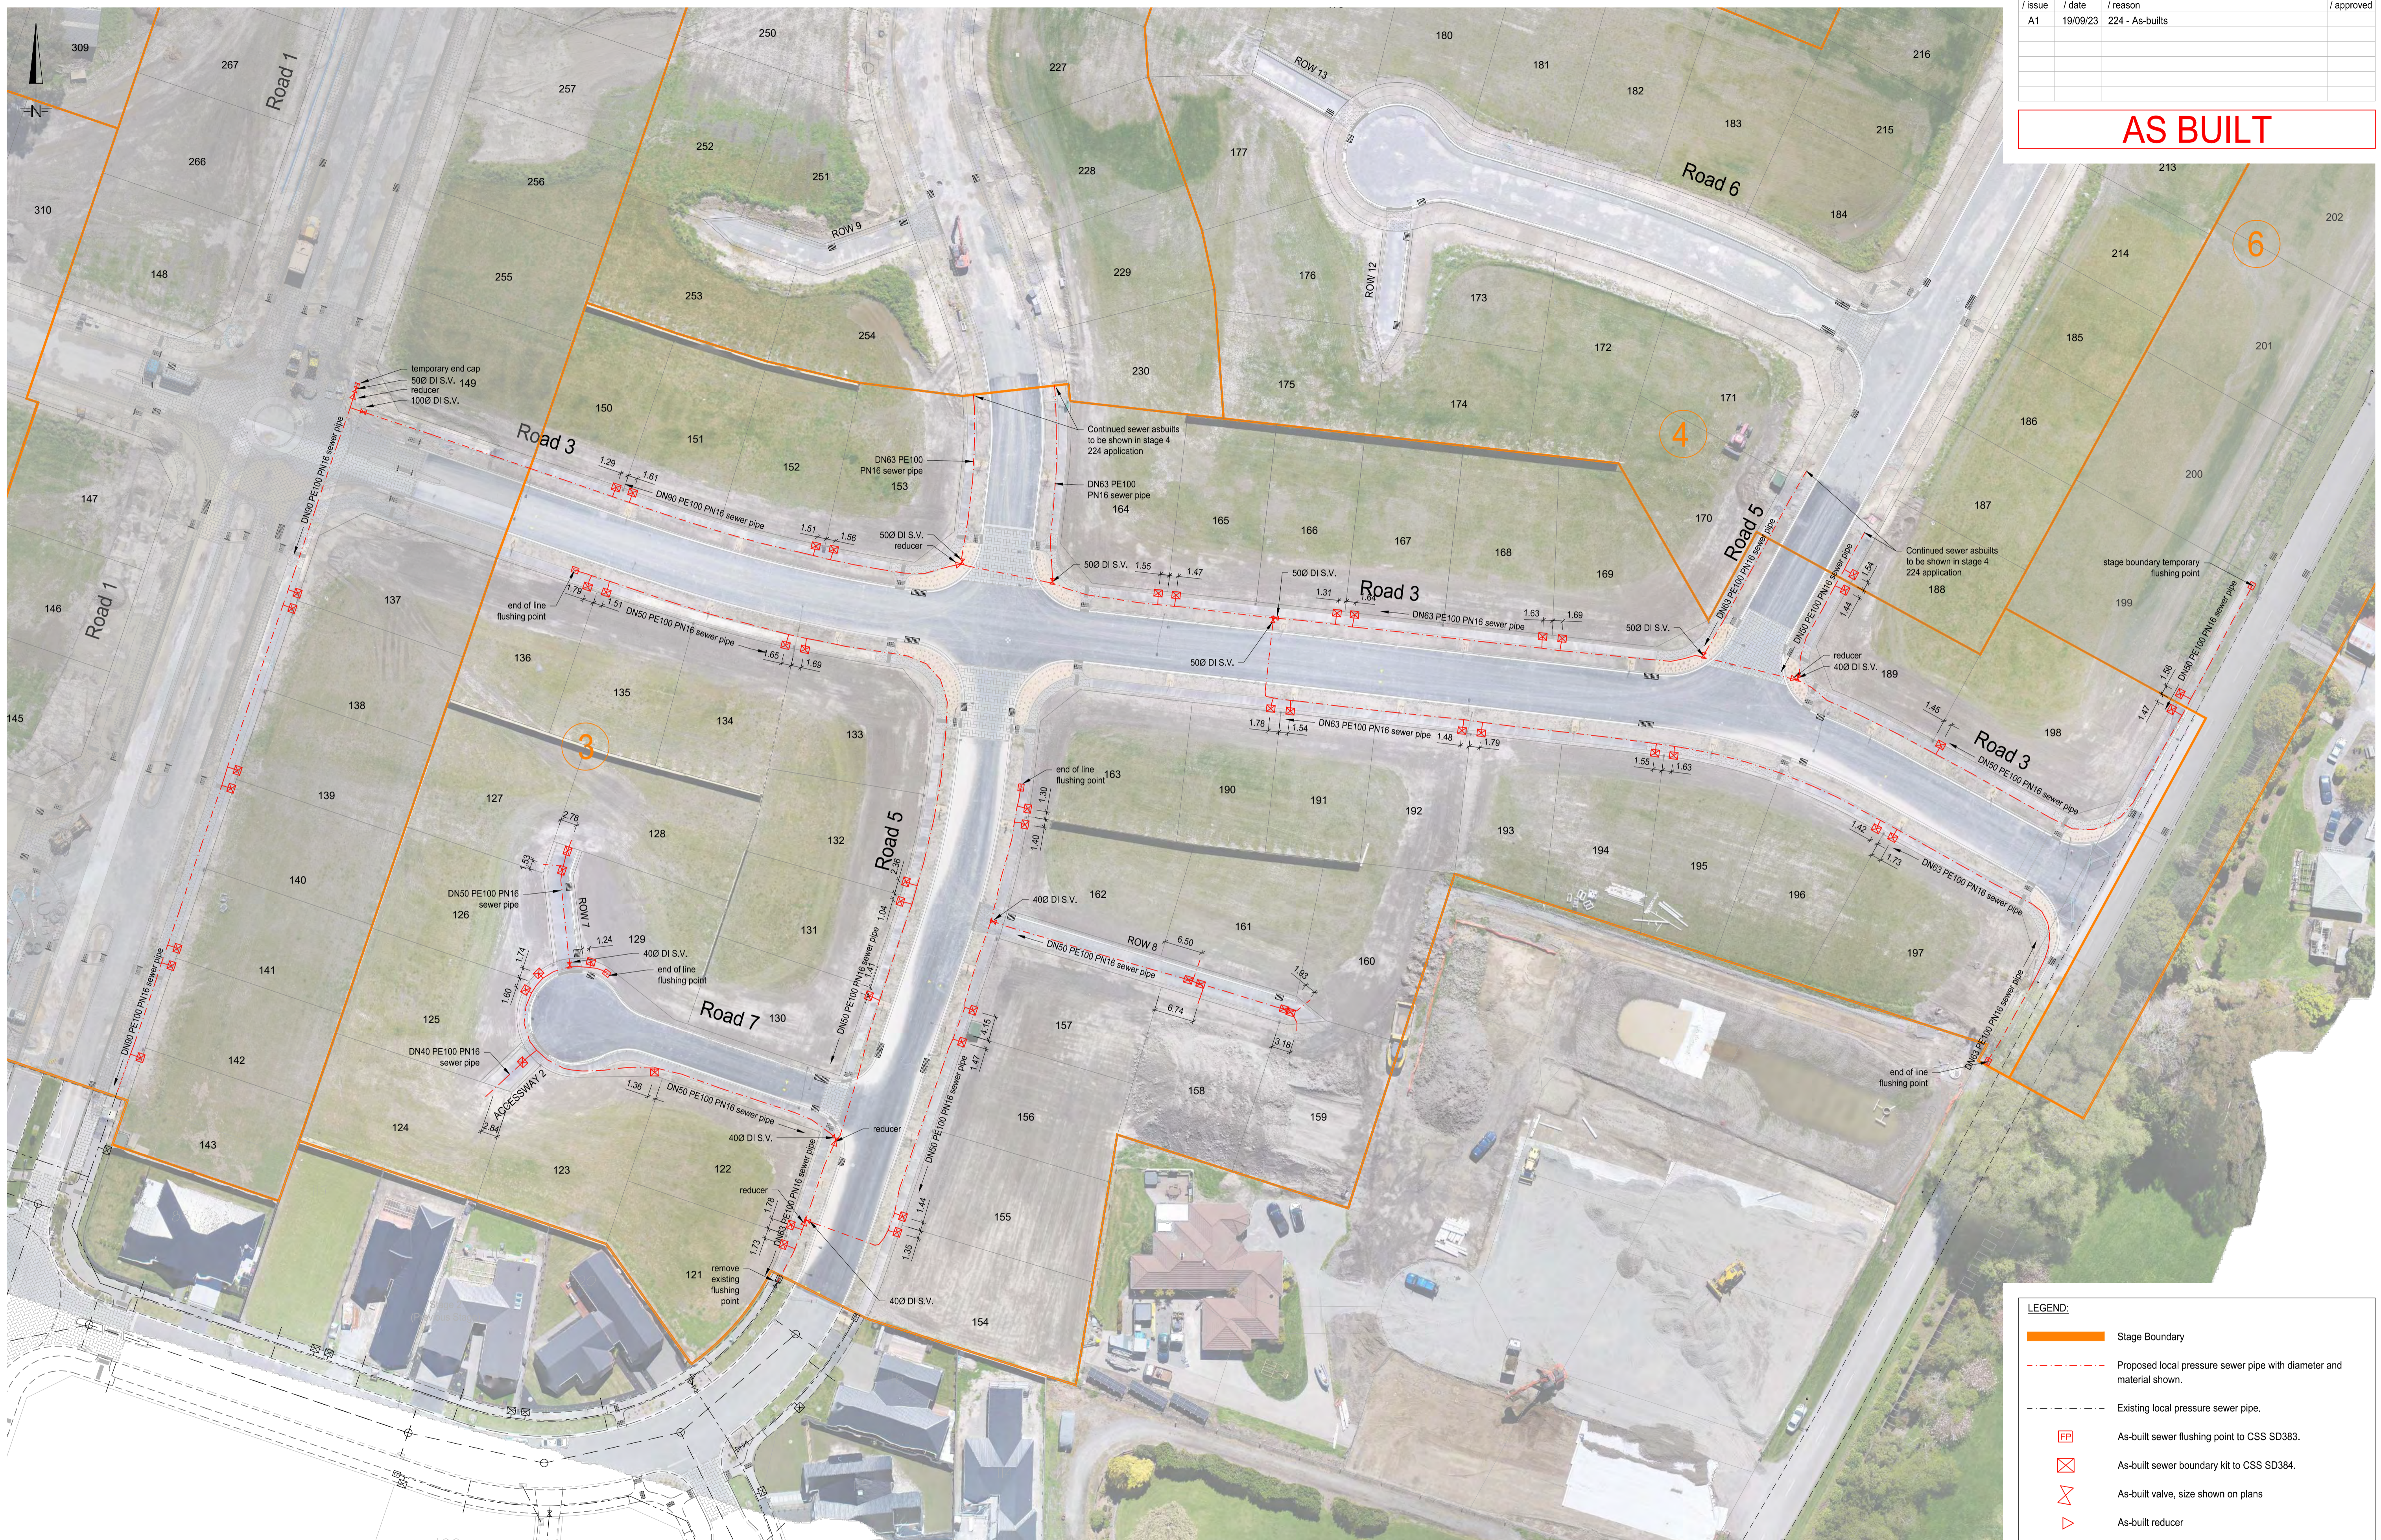

CAD ref: 39630.DwgSet2.Sewer & Stormwater.dwg

do DAVIS OGILVIE
 ENGINEERS / SURVEYORS / PLANNERS

Davis Ogilvie & Partners Limited
 Level 1, 24 Moorhouse Avenue, Addington, Christchurch 8140
 Office 0800 999 333 Email hello@do.nz
 www.do.nz

**OAKBRIDGE - PRESTONS ROAD, REDWOOD
 PROPOSED SUBDIVISION**

**AS-BUILT PLANS - STAGE 3
 SEWER AS-BUILTS**

/ design	/ drawn	/ QA check	/ dwg
DGB	SM	-	AB01
/ scale @ A1	/ date	/ file	/ issue
1:500	09/23	39630	A1

/ issue	/ date	/ reason	/ approved
AB3	19/09/23	224 - As-builts	

AS BUILT



LEGEND:

- Site boundary
- Existing water pipe
- As-built water pipe
- Ex. FH Existing Fire Hydrant
- FH As-built Fire Hydrant as per SD402 with tapped riser
- Existing Valve (sluice or gate)
- As-built Sluice Valve with diameter shown.
- As-built 50 mm Hawke gate valve on 63 PE 80B
- As-built Thrust Block
- As-built Blank End with thrust block
- As-built Blank End

CAD ref: 39630.DwgSet3.Water & Services.dwg

do DAVIS OGILVIE
 ENGINEERS / SURVEYORS / PLANNERS

Davis Ogilvie & Partners Limited
 Level 1, 24 Moorhouse Avenue, Addington, Christchurch 8140
 Office 0800 999 333 Email hello@do.nz
 www.do.nz

**OAKBRIDGE - PRESTONS ROAD, REDWOOD
 PROPOSED SUBDIVISION**

**AS-BUILT PLANS - STAGE 3
 WATER AS-BUILTS**

/ design	/ draw	/ QA check	/ dwg
DGB	SM		AB04
/ scale @ A1	/ date	/ file	/ issue
1:500	09/23	39630	C1