

Title

**PREVELLES, PREBBLETON
SEWER ASBUILTS**

Origin of Levels - BM EKG6, Capped SS, Cnr Halswell Junction Rd and Springs Rd. RL 23.311

Level Datum - Christchurch Drainage Datum

Drawn	SM	Date	19/02/21
		QA check	CP

AutoCAD ref: 195533-ASBUILTS

Sheet .


Drawing **AB1**

Scale @A3 1:500
Scale @A1 1:250

Revision **A**

LEGEND

- Sewer pipe
- Sewer manhole
- Water supply pipe
- Water meter
- Valve
- Fire hydrant
- Thrust block
- Stormwater pipe
- Stormwater manhole (circular)
- Stormwater manhole (square)
- Single sump
- Double sump

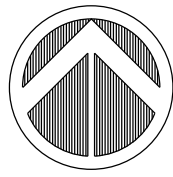

LEGEND			
	Sewer pipe		Sewer manhole
	Water supply pipe		Water meter
	Valve		Fire hydrant
	Thrust block		Stormwater pipe
	Stormwater manhole (circular)		Stormwater manhole (square)
	Single sump		Double sump

Title			
PREVELLES, PREBBLETON SEWER ASBUILTS			

Origin of Levels - BM EKQ6, Capped SS, Cnr Halswell Junction Rd and Springs Rd. RL 23.311			
Level Datum - Christchurch Drainage Datum			
Drawn	SM	Date	19/02/21
		QA check	CP

A	19/02/21	224 Application	CP
issue	date	reason	approved
AutoCAD ref: 195533-ASBUILTS		Scale @A3	1:500
Sheet .		Scale @A1	1:250
Drawing AB2		Revision A	



Title
**PREVELLES, PREBBLETON
SEWER ASBUILTS**

Origin of Levels - BM EKQ6, Capped SS, Cnr Halswell Junction Rd and Springs Rd. RL 23.311			
Level Datum - Christchurch Drainage Datum			
Date		19/02/21	
Drawn	SM	QA check	CP

A	19/02/21	224 Application	CP
issue	date	reason	approved


AutoCAD ref: **195533-ASBUILTS**
Sheet .

Scale @A3 1:500
Scale @A1 1:250

Drawing **AB3**

Revision **A**


LEGEND	
	Sewer pipe
	Sewer manhole
	Water supply pipe
	Water meter
	Valve
	Fire hydrant
	Thrust block
	Stormwater pipe
	Stormwater manhole (circular)
	Stormwater manhole (square)
	Single sump
	Double sump

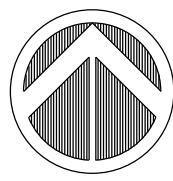

LEGEND			
	Sewer pipe		Sewer manhole
	Water supply pipe		Water meter
	Valve		Fire hydrant
	Thrust block		Stormwater pipe
	Stormwater manhole (circular)		Stormwater manhole (square)
	Single sump		Double sump

Drawn	SM	Date	19/02/21
		QA check	CP

A	19/02/21	224 Application	CP
issue	date	reason	approved

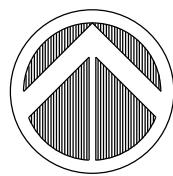


LEGEND			
	Sewer pipe		Water supply pipe
	Sewer manhole		Water meter
	Valve		Fire hydrant
	Thrust block		Stormwater pipe
	Stormwater manhole (circular)		Stormwater manhole (square)
	Single sump		Double sump

Title

**PREVELLES, PREBBLETON
WATER SUPPLY ASBUILTS**

Origin of Levels - BM EKG6, Capped SS, Cnr Halswell Junction Rd and Springs Rd. RL 23.311			
Level Datum - Christchurch Drainage Datum			
Drawn	SM	Date	19/02/21
		QA check	CP



AutoCAD ref: 195533-ASBUILTS			
Sheet .			
Scale @A3 1:500		Scale @A1 1:250	
Drawing AB5		Revision A	

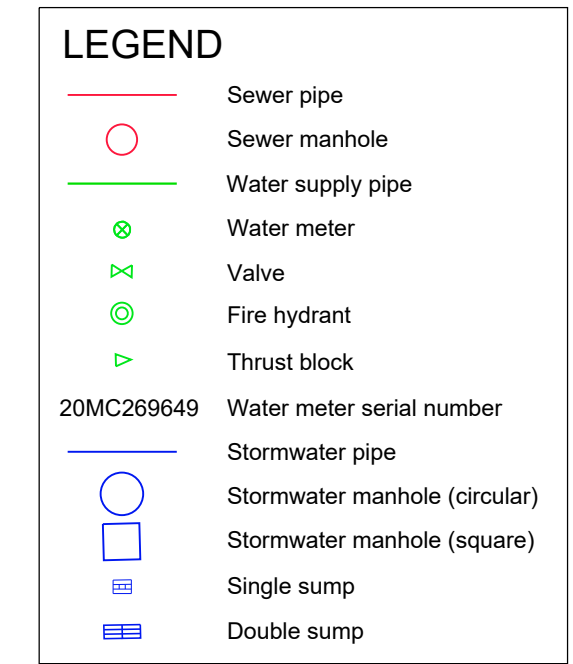

Origin of Levels - BM EKQ6, Capped SS, Cnr Halswell Junction Rd and Springs Rd. RL 23.311			
Level Datum - Christchurch Drainage Datum			
		Date	19/02/21
Drawn	SM	QA check	CP

Scale @ A3 1:500
Scale @ A1 1:250

Revision **A**

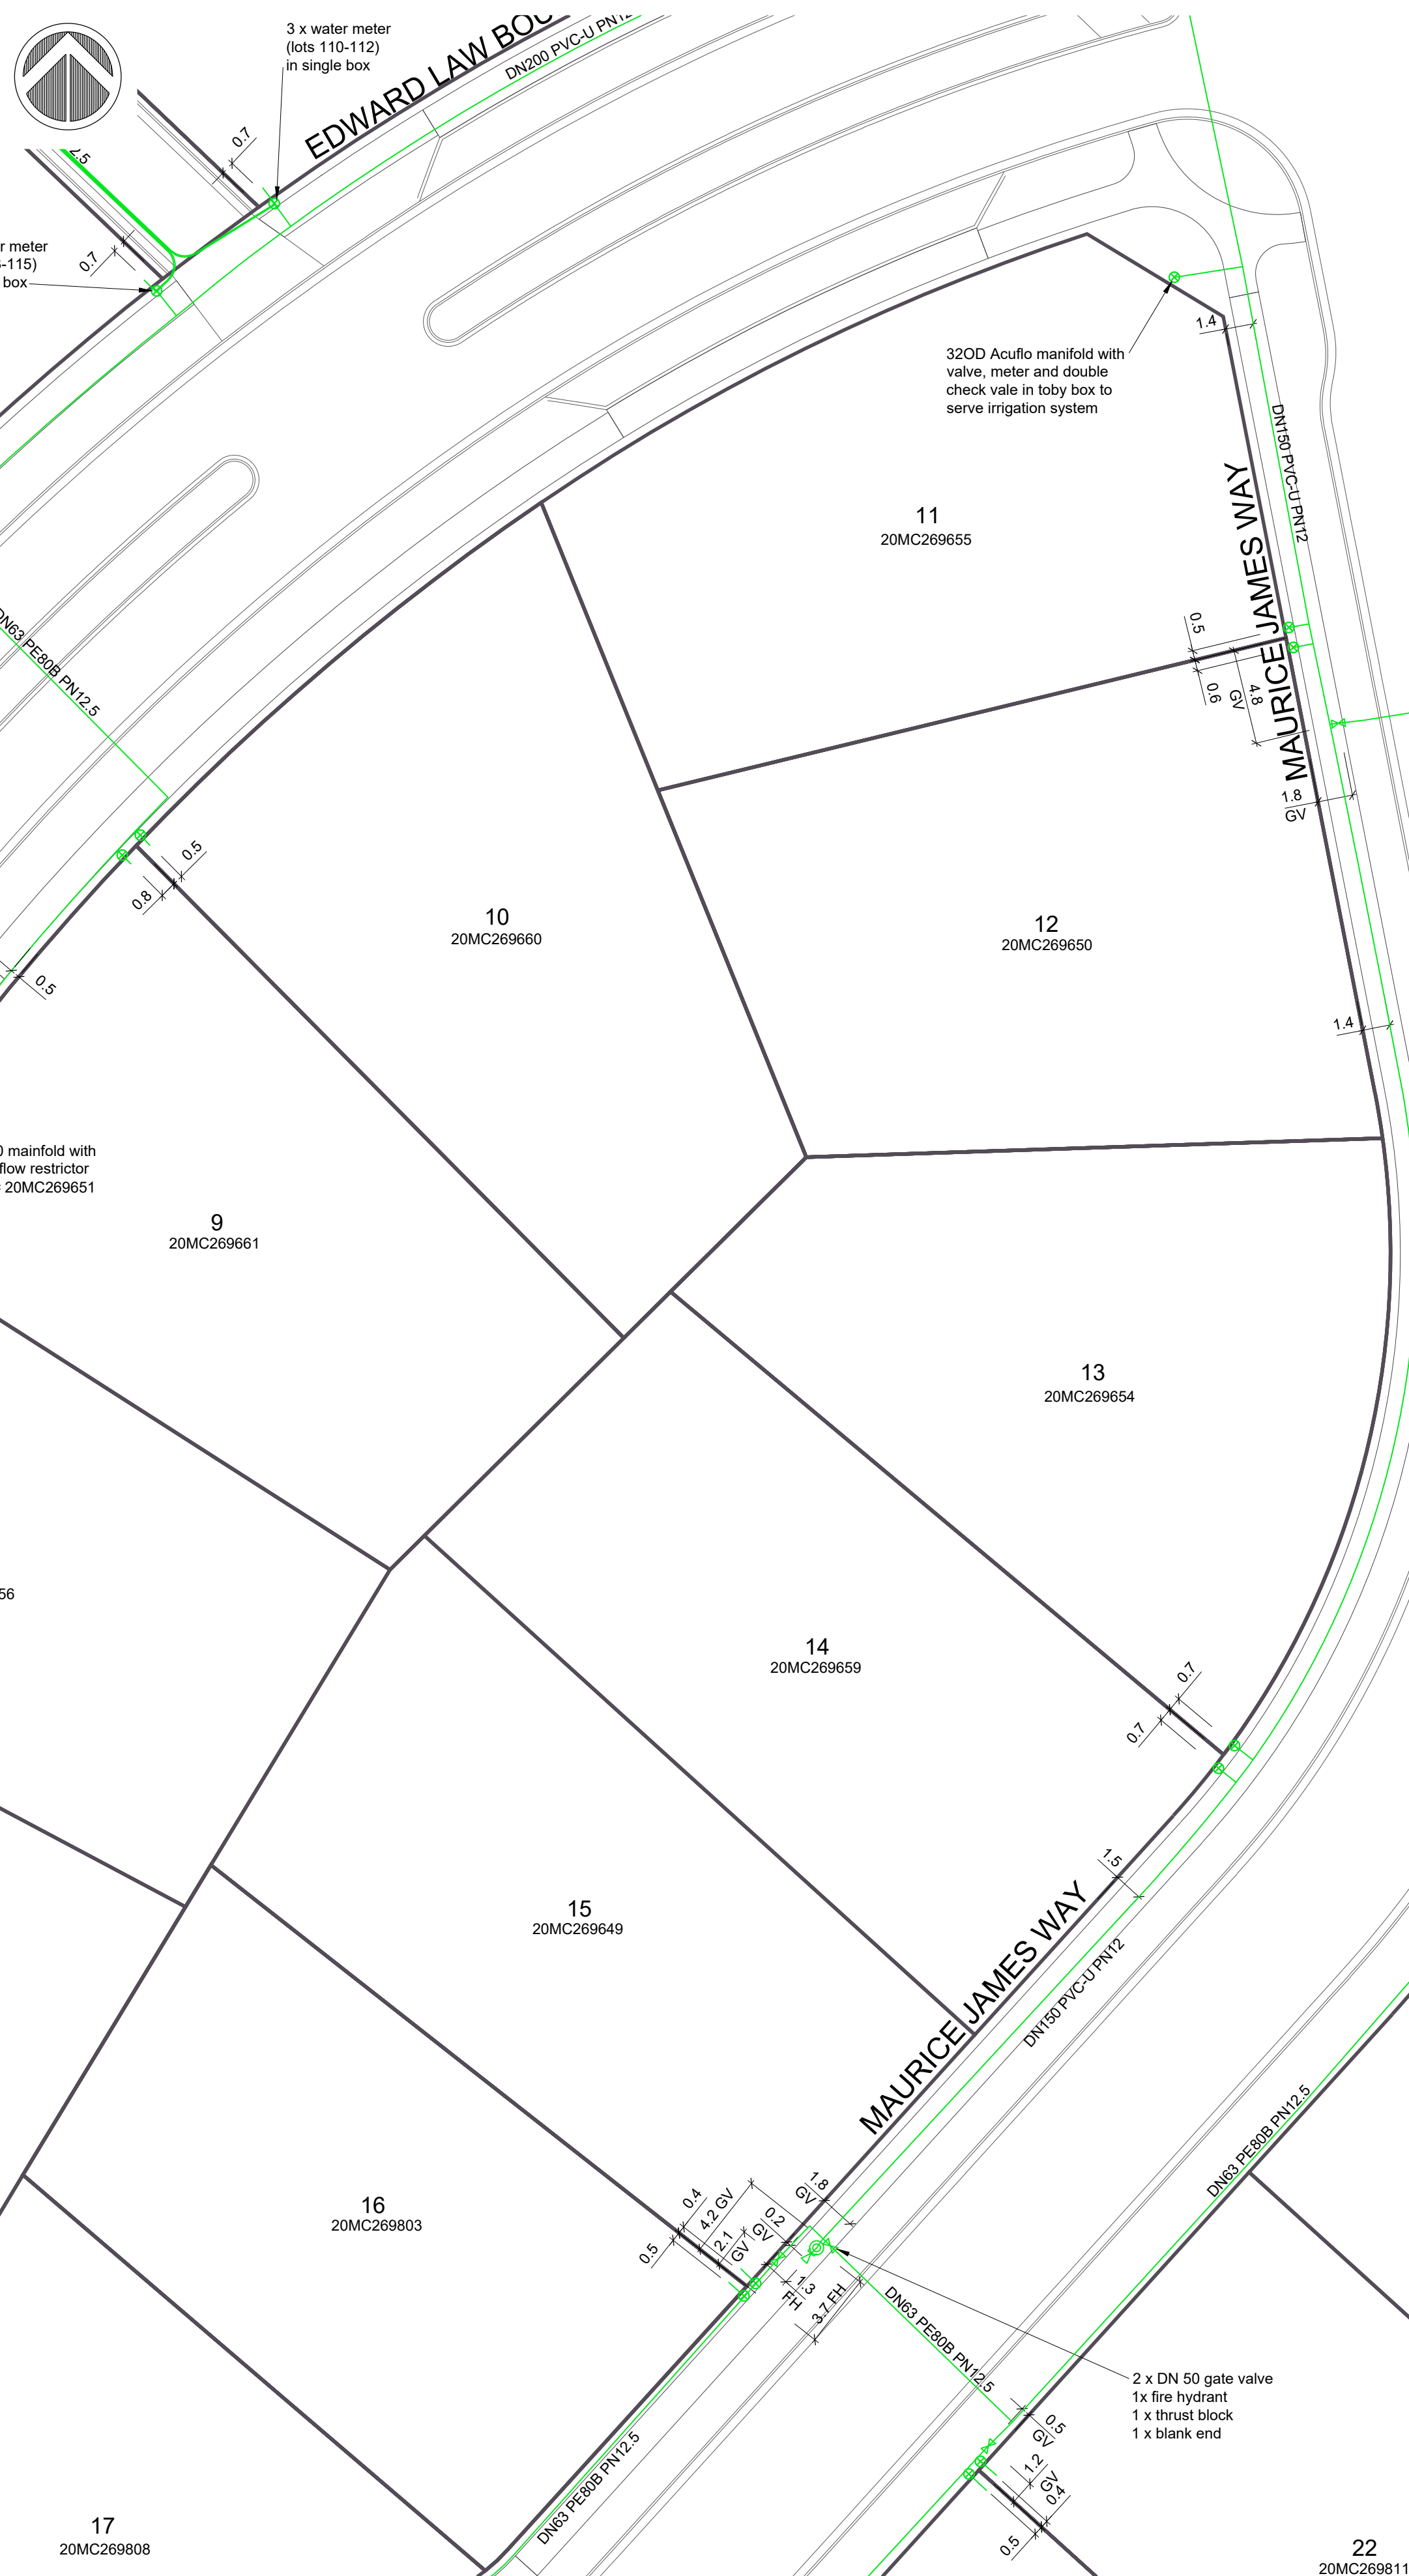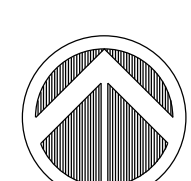

Title

PREVELLES, PREBBLETON WATER SUPPLY ASBUILTS


Origin of Levels - BM EKQ6, Capped SS, Cnr Halswell Junction Rd and Springs Rd. RL 23.311			
Level Datum - Christchurch Drainage Datum			
Date		19/02/21	
Drawn	SM	QA check	CP

A	19/02/21	224 Application	CP
issue	date	reason	approved

AutoCAD ref: 195533-ASBUILTS
Sheet .

Scale @A3 1:500
Scale @A1 1:250

Drawing **AB7**
Revision **A**

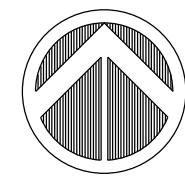

LEGEND

- Sewer pipe
- Sewer manhole
- Water supply pipe
- Water meter
- Valve
- Fire hydrant
- Thrust block
- 20MC269649 Water meter serial number
- Stormwater pipe
- Stormwater manhole (circular)
- Stormwater manhole (square)
- Single sump
- Double sump

Title

PREVELLES, PREBBLETON
WATER SUPPLY ASBUILTS

Origin of Levels - BM EKQ6, Capped SS, Cnr Halswell Junction Rd and Springs Rd. RL 23.311

Level Datum - Christchurch Drainage Datum

Drawn	SM	Date	19/02/21
		QA check	CP

AutoCAD ref: 195533-ASBUILTS



Sheet .

Drawing **AB8**

Scale @A3 1:500
Scale @A1 1:250

Revision **A**

A	19/02/21	224 Application	CP
issue	date	reason	approved

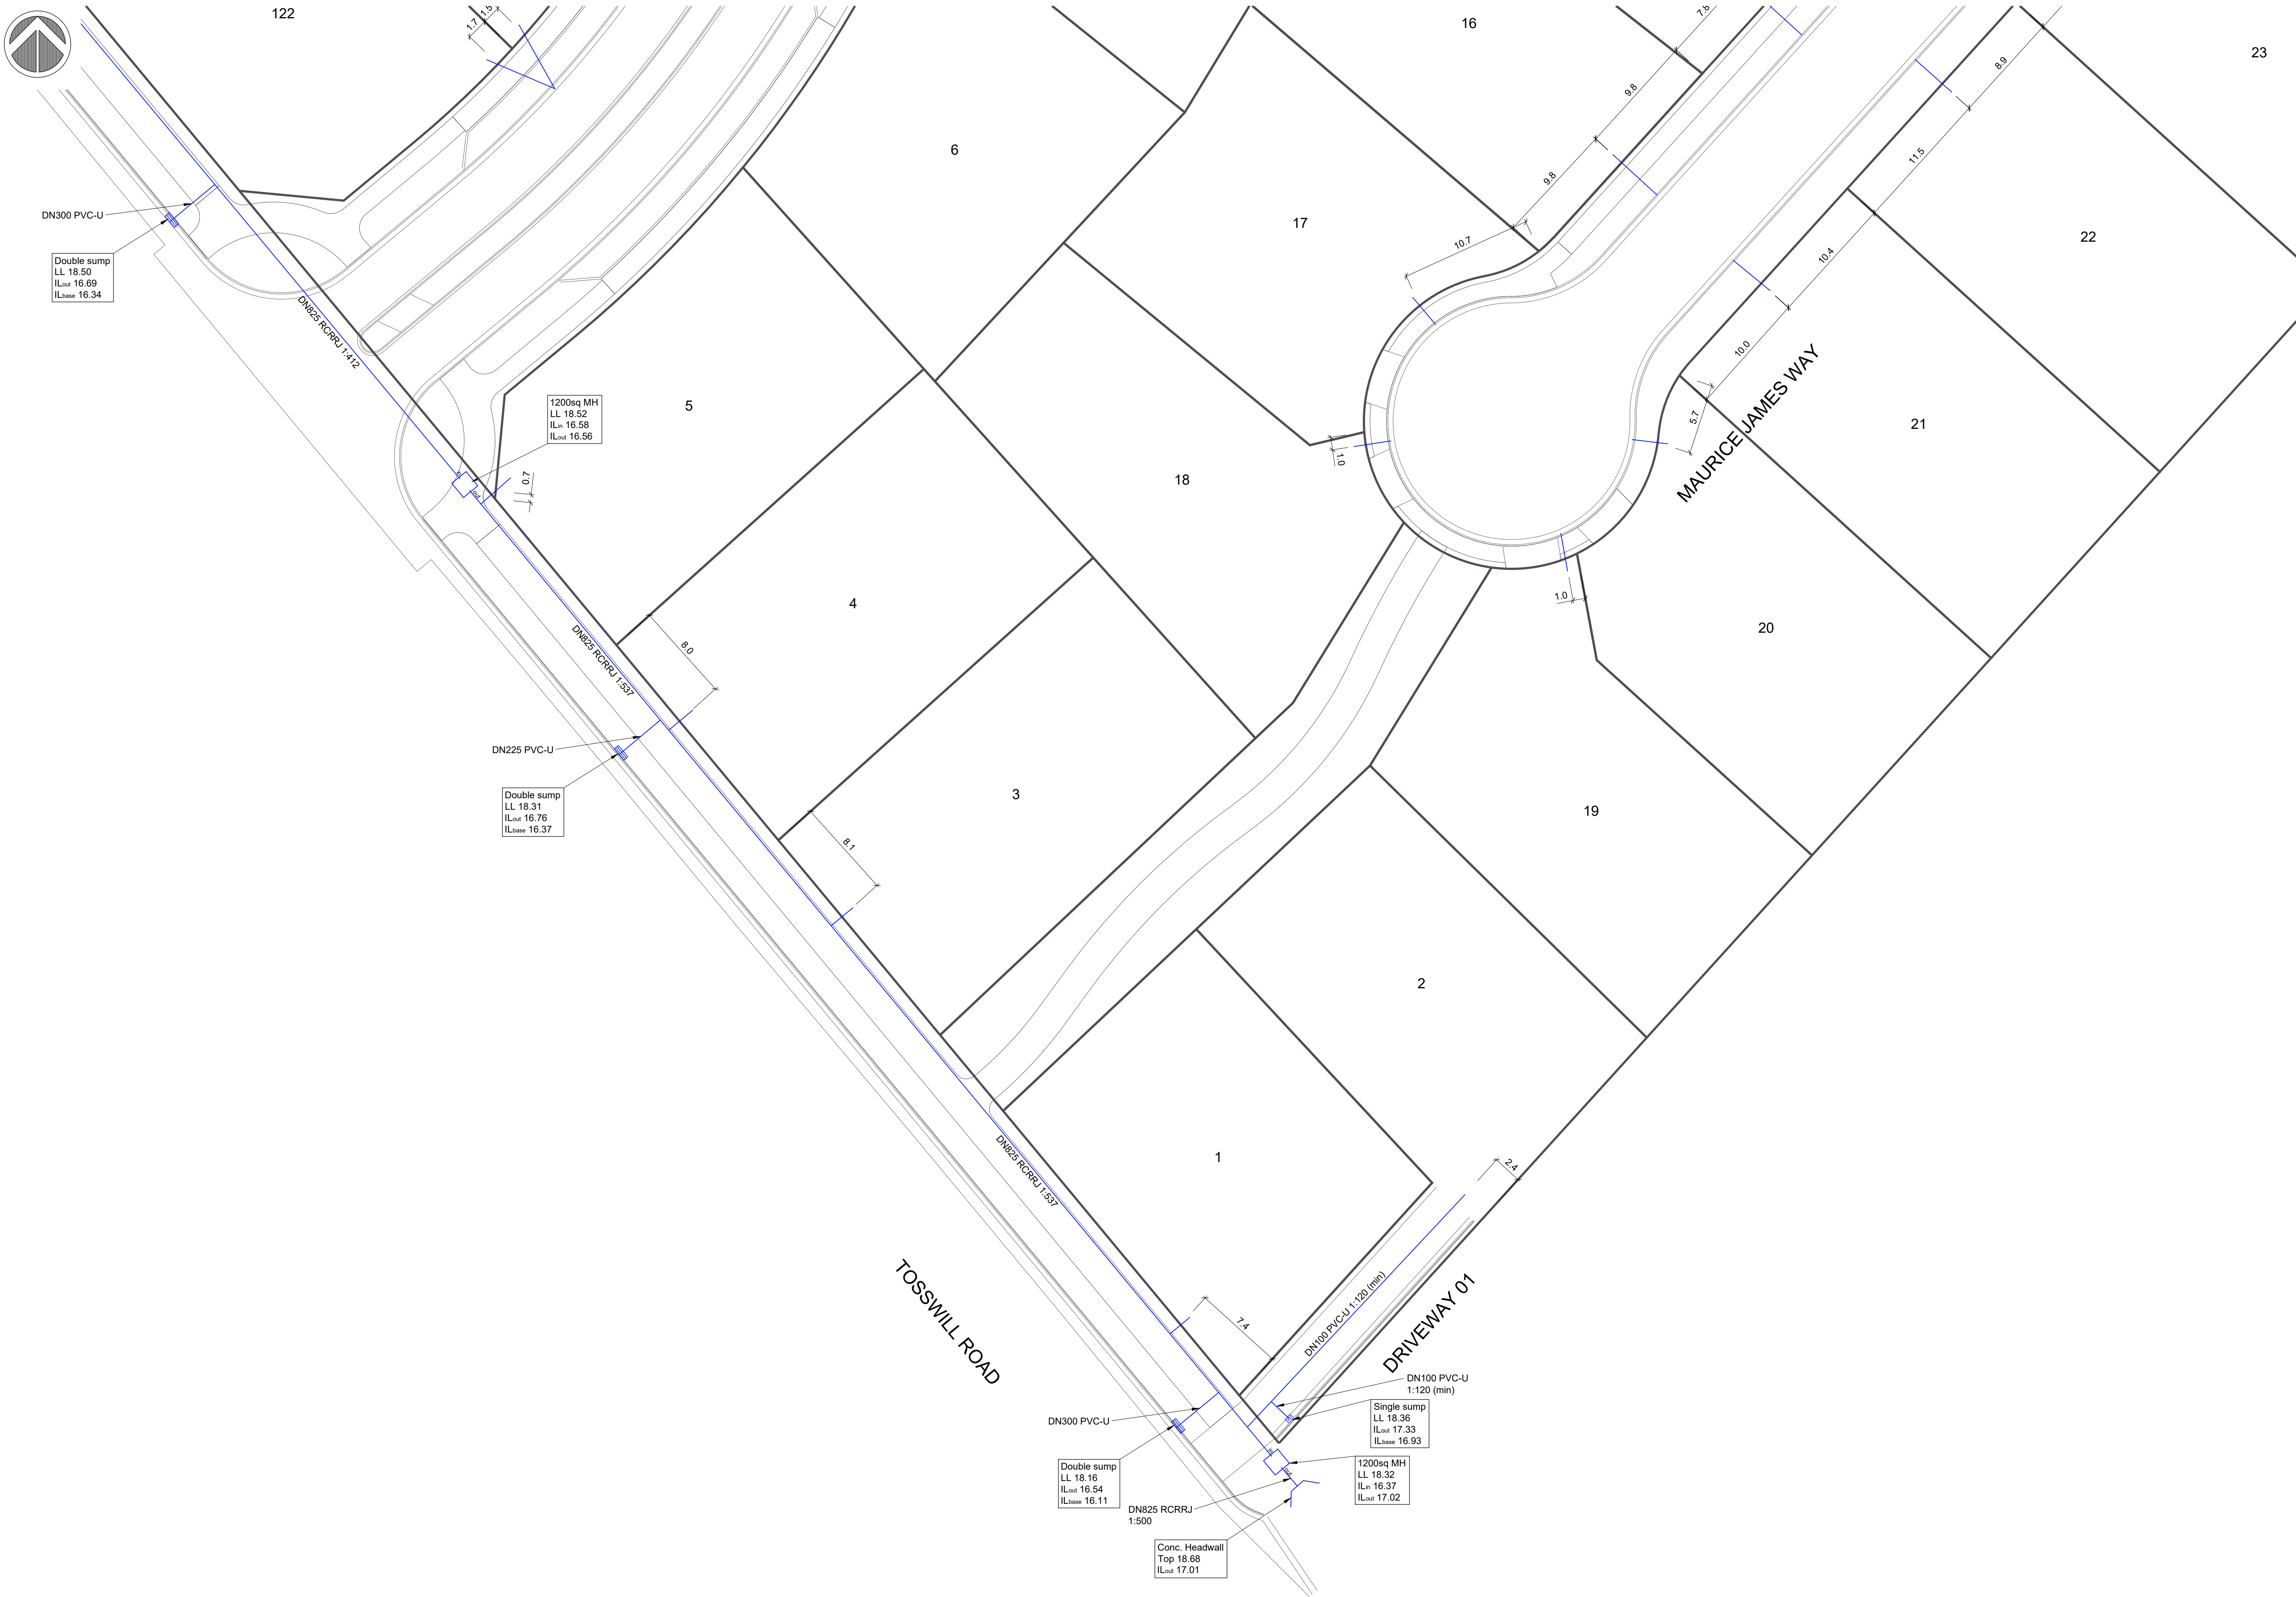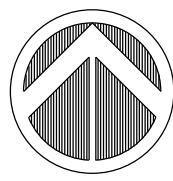

LEGEND			
	Sewer pipe		Sewer manhole
	Water supply pipe		Water meter
	Valve		Fire hydrant
	Thrust block		Stormwater pipe
	Stormwater manhole (circular)		Stormwater manhole (square)
	Single sump		Double sump

Title

**PREVELLES, PREBBLETON
STORMWATER ASBUILTS**

Origin of Levels - BM EKQ6, Capped SS, Cnr Halswell Junction Rd and Springs Rd. RL 23.311
Level Datum - Lyttelton 1937

Drawn	SM	Date	19/02/21
QA check	CP		



issue	date	reason	approved
A	19/02/21	224 Application	CP

AutoCAD ref: **195533-ASBUILTS**
Sheet .

Drawing **AB9**

Scale @A3 1:500
Scale @A1 1:250


Revision **A**

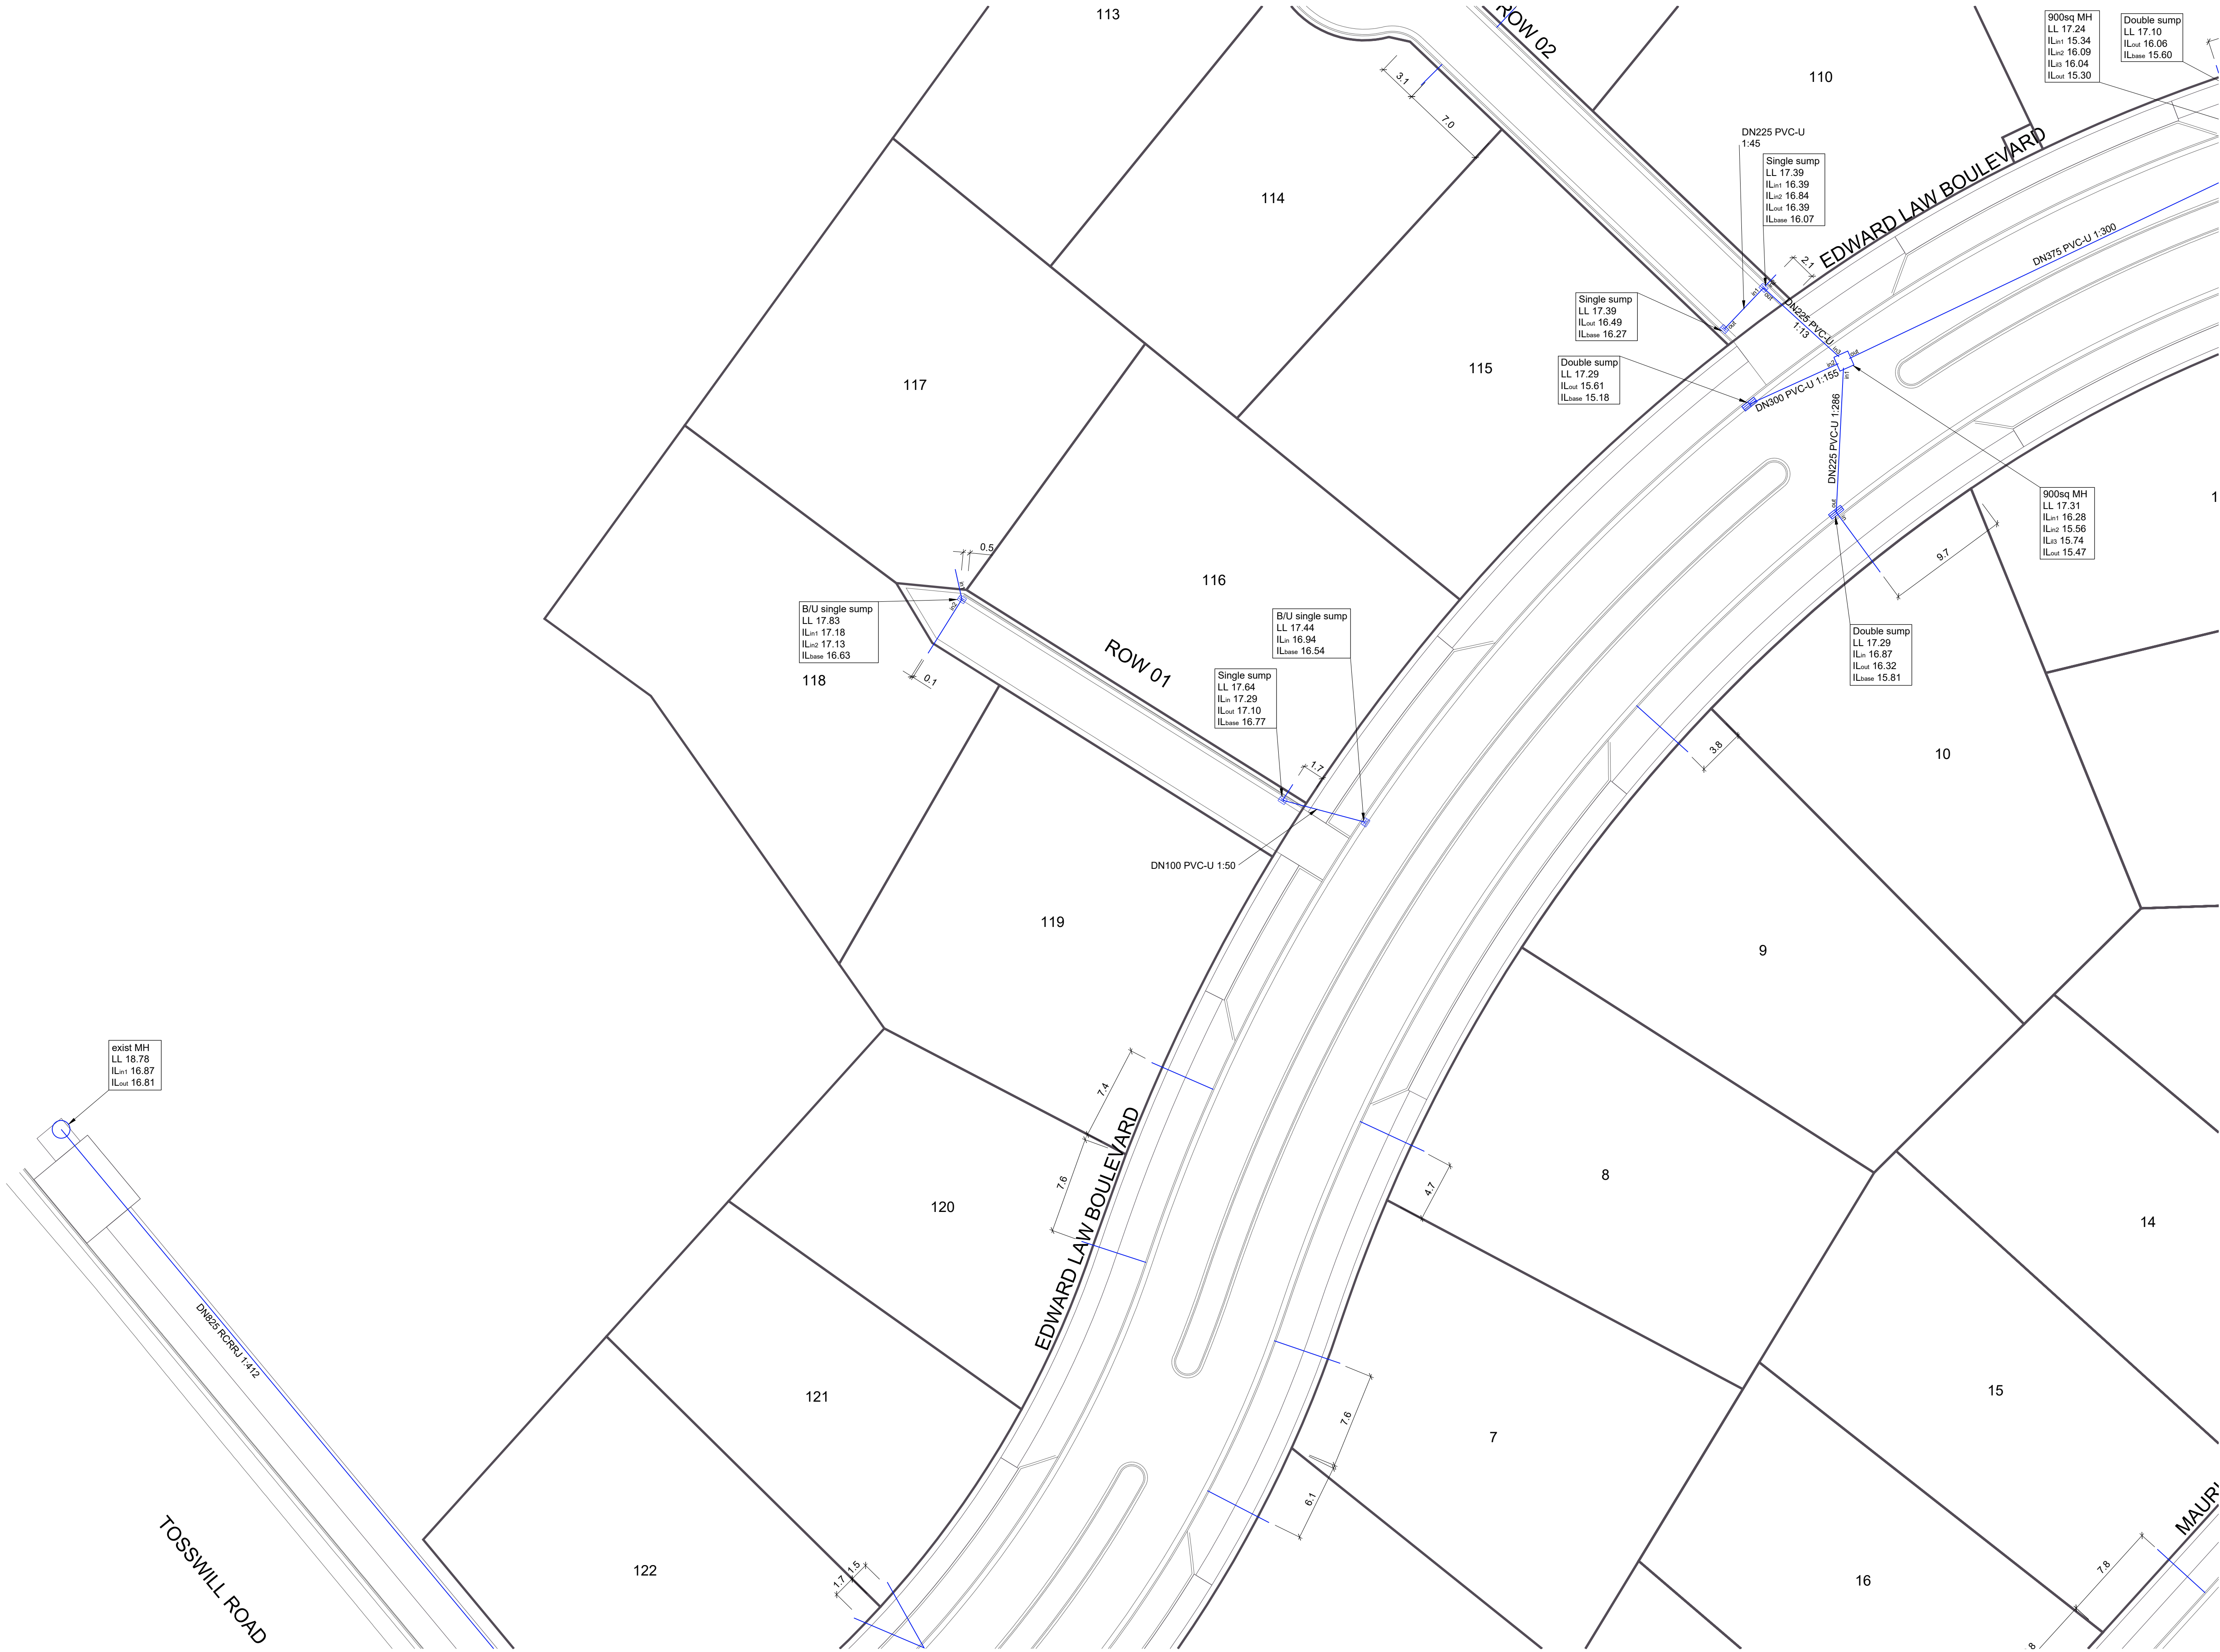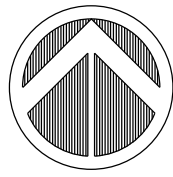

LEGEND

- Sewer pipe
- Sewer manhole
- Water supply pipe
- Water meter
- Valve
- Fire hydrant
- Thrust block
- 20MC269649 Water meter serial number
- Stormwater pipe
- Stormwater manhole (circular)
- Stormwater manhole (square)
- Single sump
- Double sump

Title				Origin of Levels - BM EKQ6, Capped SS, Cnr Halswell Junction Rd and Springs Rd. RL 23.311				AutoCAD ref: 195533-ASBuILTS				Scale @A3 1:500	
PREVELLES, PREBBLETON				Level Datum - Lyttelton 1937				Sheet .		Scale @A1 1:250		Revision A	
STORMWATER ASBuILTS								Drawing AB10					
Drawn		SM		Date		19/02/21							
				QA check		CP							

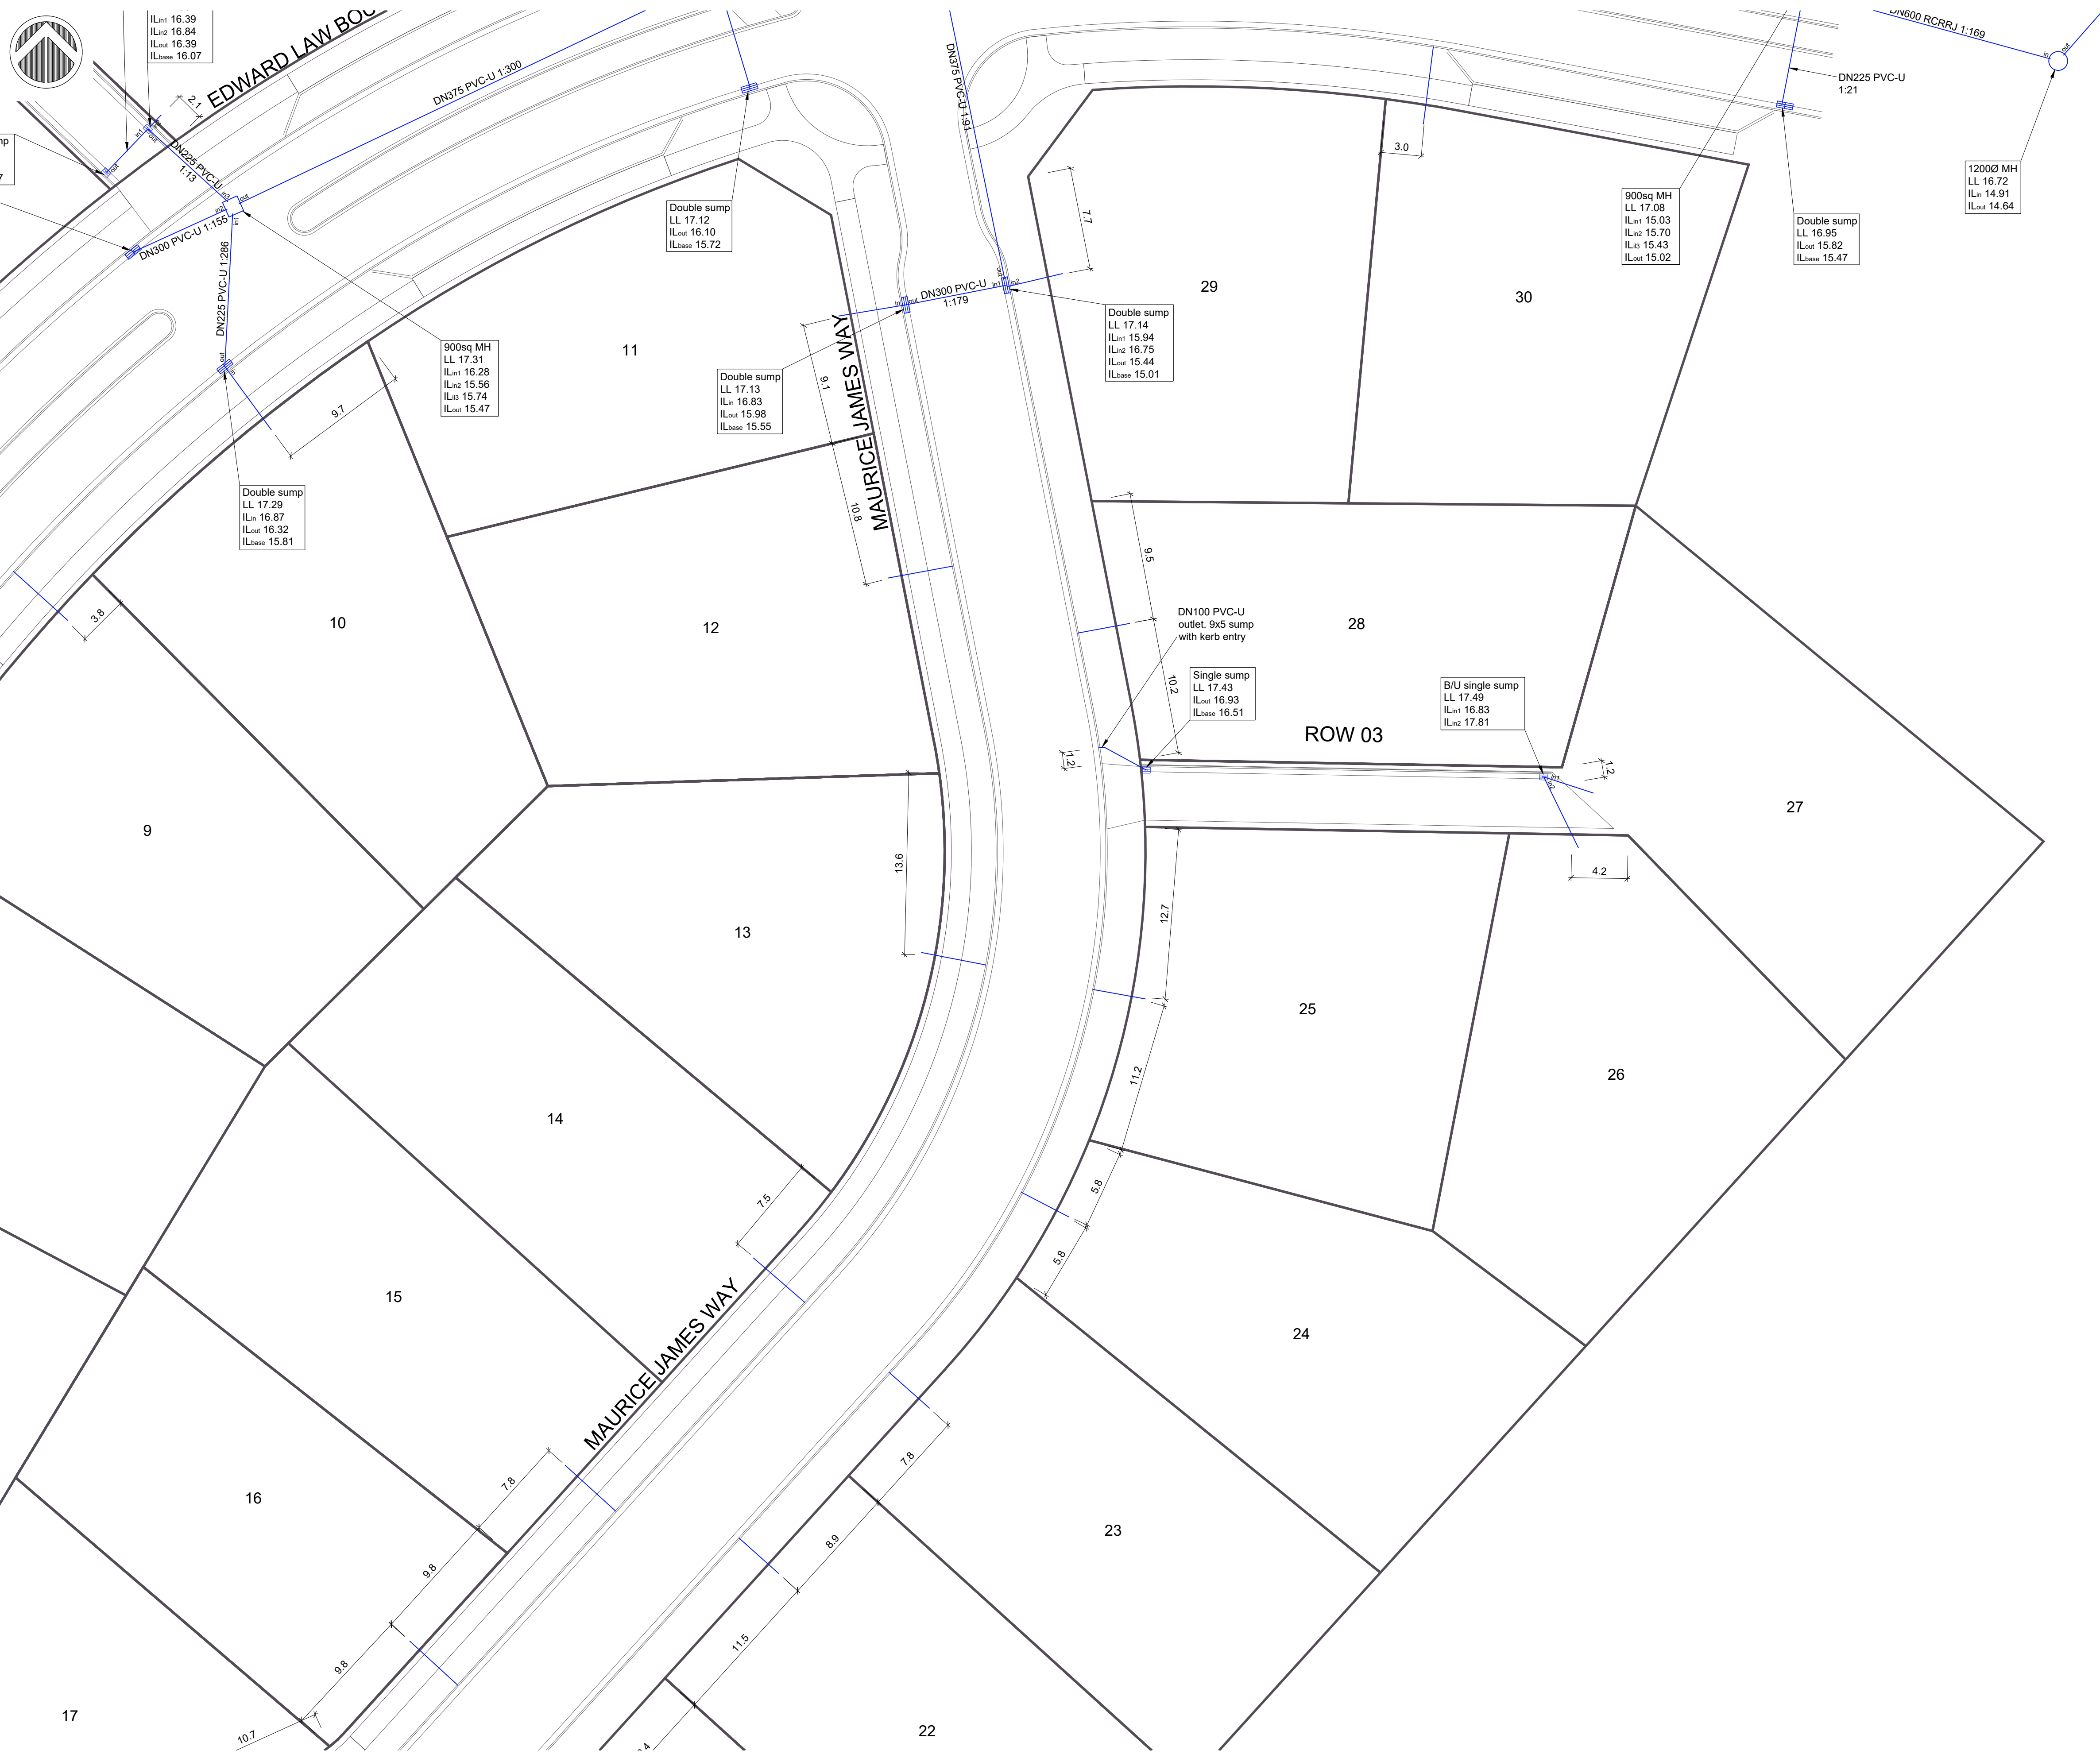

Title

**PREVELLES, PREBBLETON
STORMWATER ASBuILTS**

Origin of Levels - BM EKG6, Capped SS, Cnr Halswell Junction Rd and Springs Rd. RL 23.311
Level Datum - Lyttelton 1937

Drawn	SM	Date	19/02/21
		QA check	CP

AutoCAD ref: 195533-ASBuILTS
Sheet .


Drawing **AB11**


Scale @A3 1:500
Scale @A1 1:250

Revision **A**


LEGEND

- Sewer pipe
- Sewer manhole
- Water supply pipe
- Water meter
- Valve
- Fire hydrant
- Thrust block
- 20MC269649 Water meter serial number
- Stormwater pipe
- Stormwater manhole (circular)
- Stormwater manhole (square)
- Single sump
- Double sump

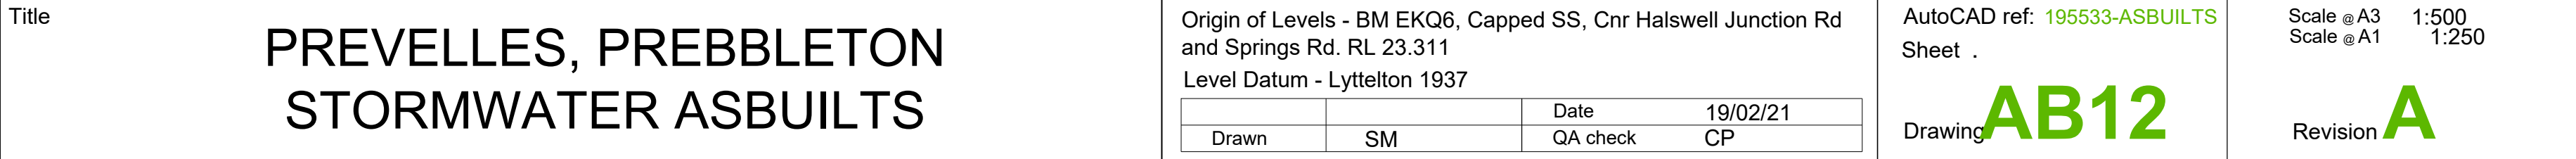

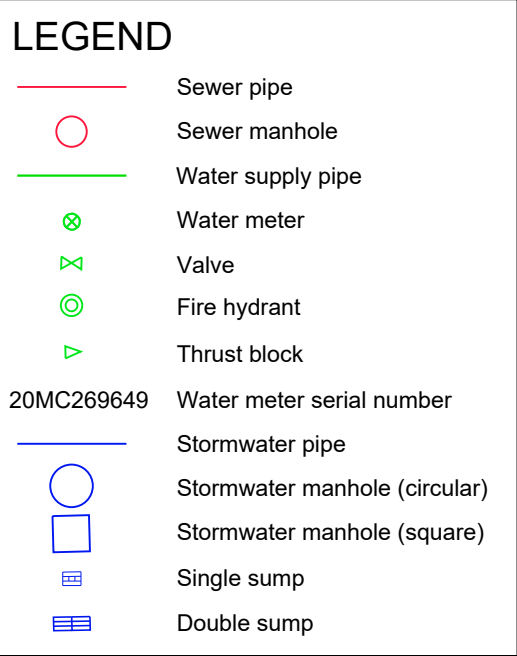

AutoCAD ref: 195533-ASBUILTS	Scale @ A3 1:1000
Sheet .	Scale @ A1 1:500
Drawing AB13	Revision A

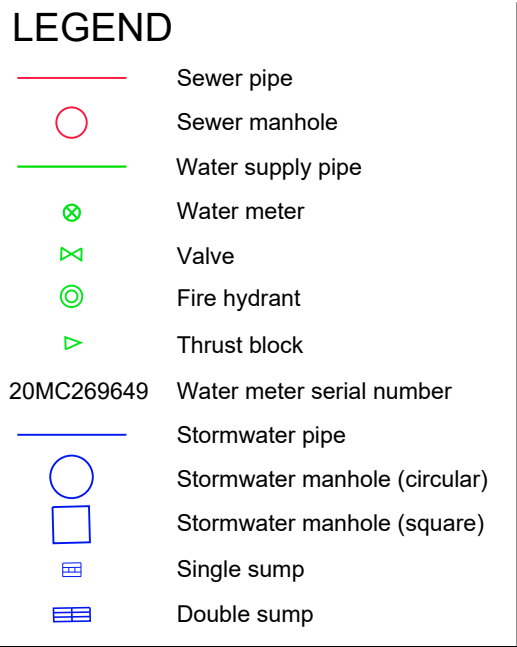

AutoCAD ref: 195533-ASBUILTS	Scale @ A3 1:1000
Sheet .	Scale @ A1 1:500
Drawing AB14	Revision B