



/ issue	/ date	/ reason	/ approved
A1	23/12/25	224 - As-builts	

AS BUILT



CAD ref: 39630.Stage 6 Sewer Asbuilts.dwg

/ issue	/ date	/ reason	/ approved
A1	23/12/25	224 - As-builts	

AS BUILT



CAD ref: 39630.DwgSet2.Sewer & Stormwater.dwg


/ issue	/ date	/ reason	/ approved
A1	23/12/25	224 - As-builts	

AS BUILT



/ issue	/ date	/ reason	/ approved
A1	23/12/25	224 - As-builts	

AS BUILT

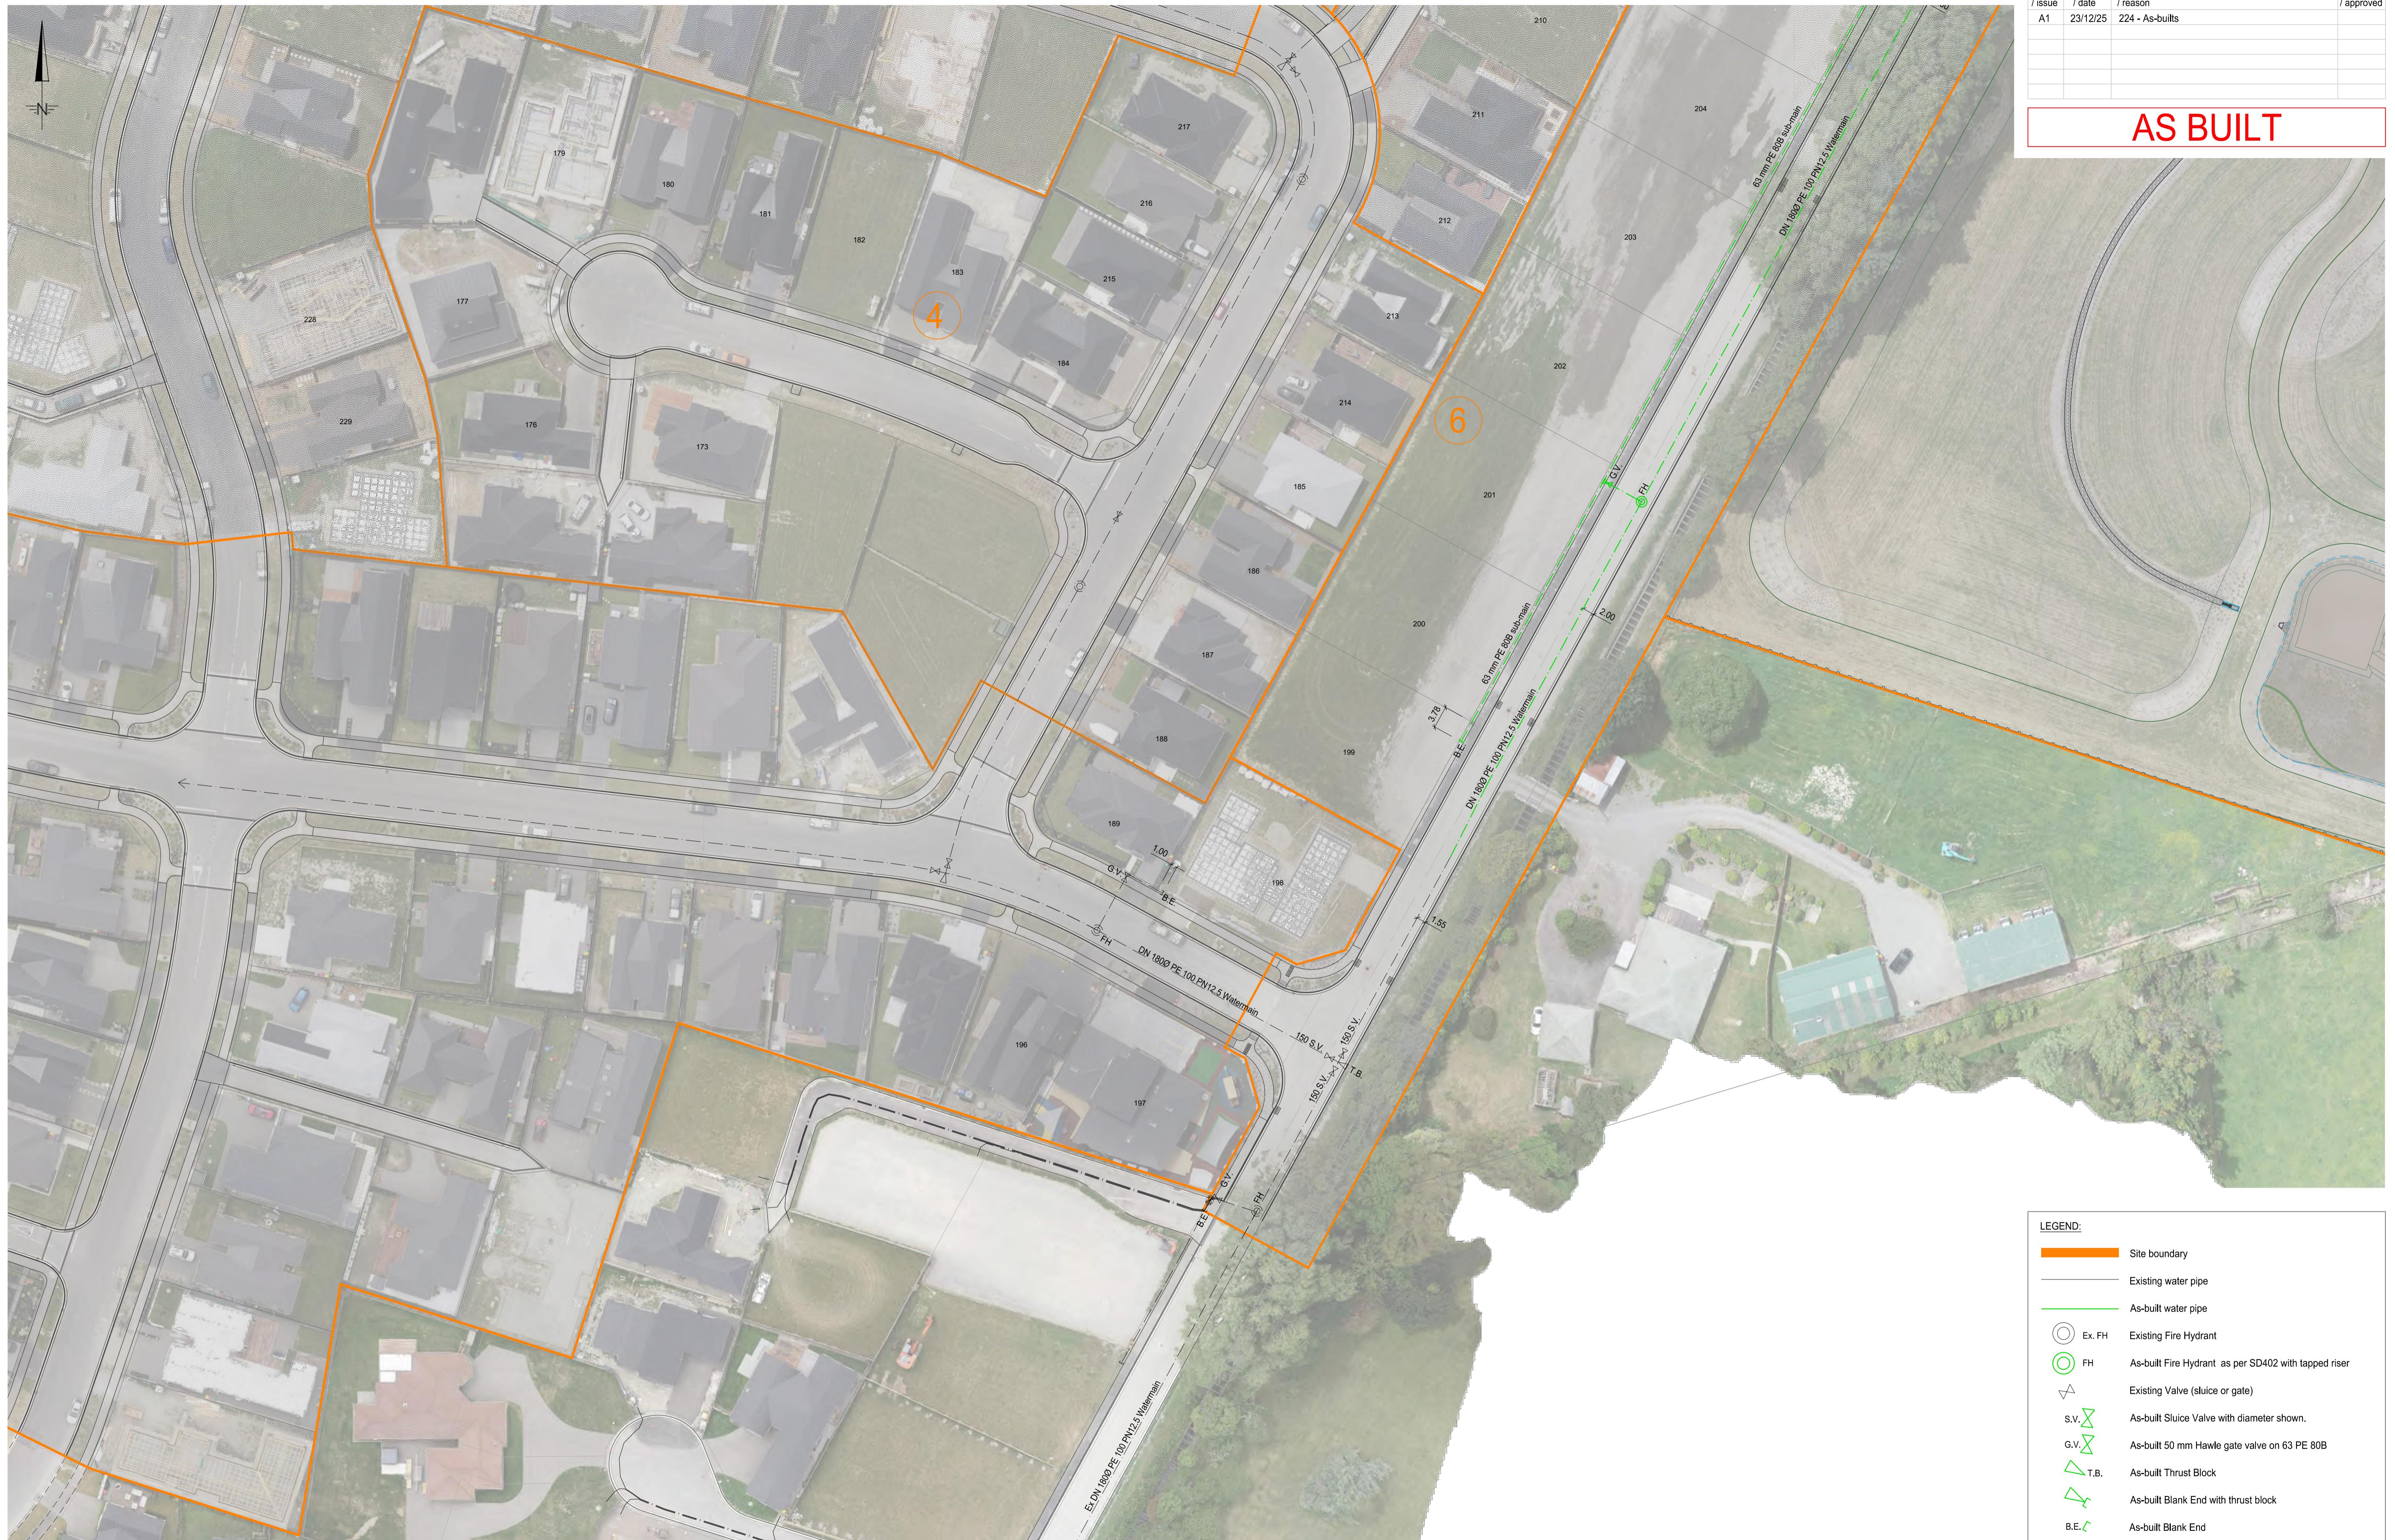

CAD ref: 39630.DwgSet3.Water & Services.dwg

/ issue	/ date	/ reason	/ approved
A1	23/12/25	224 - As-builts	

AS BUILT



CAD ref: 39630.DwgSet3.Water & Services.dwg