
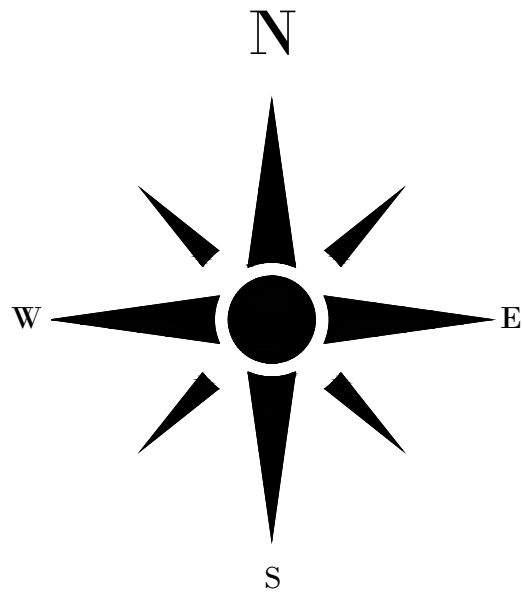


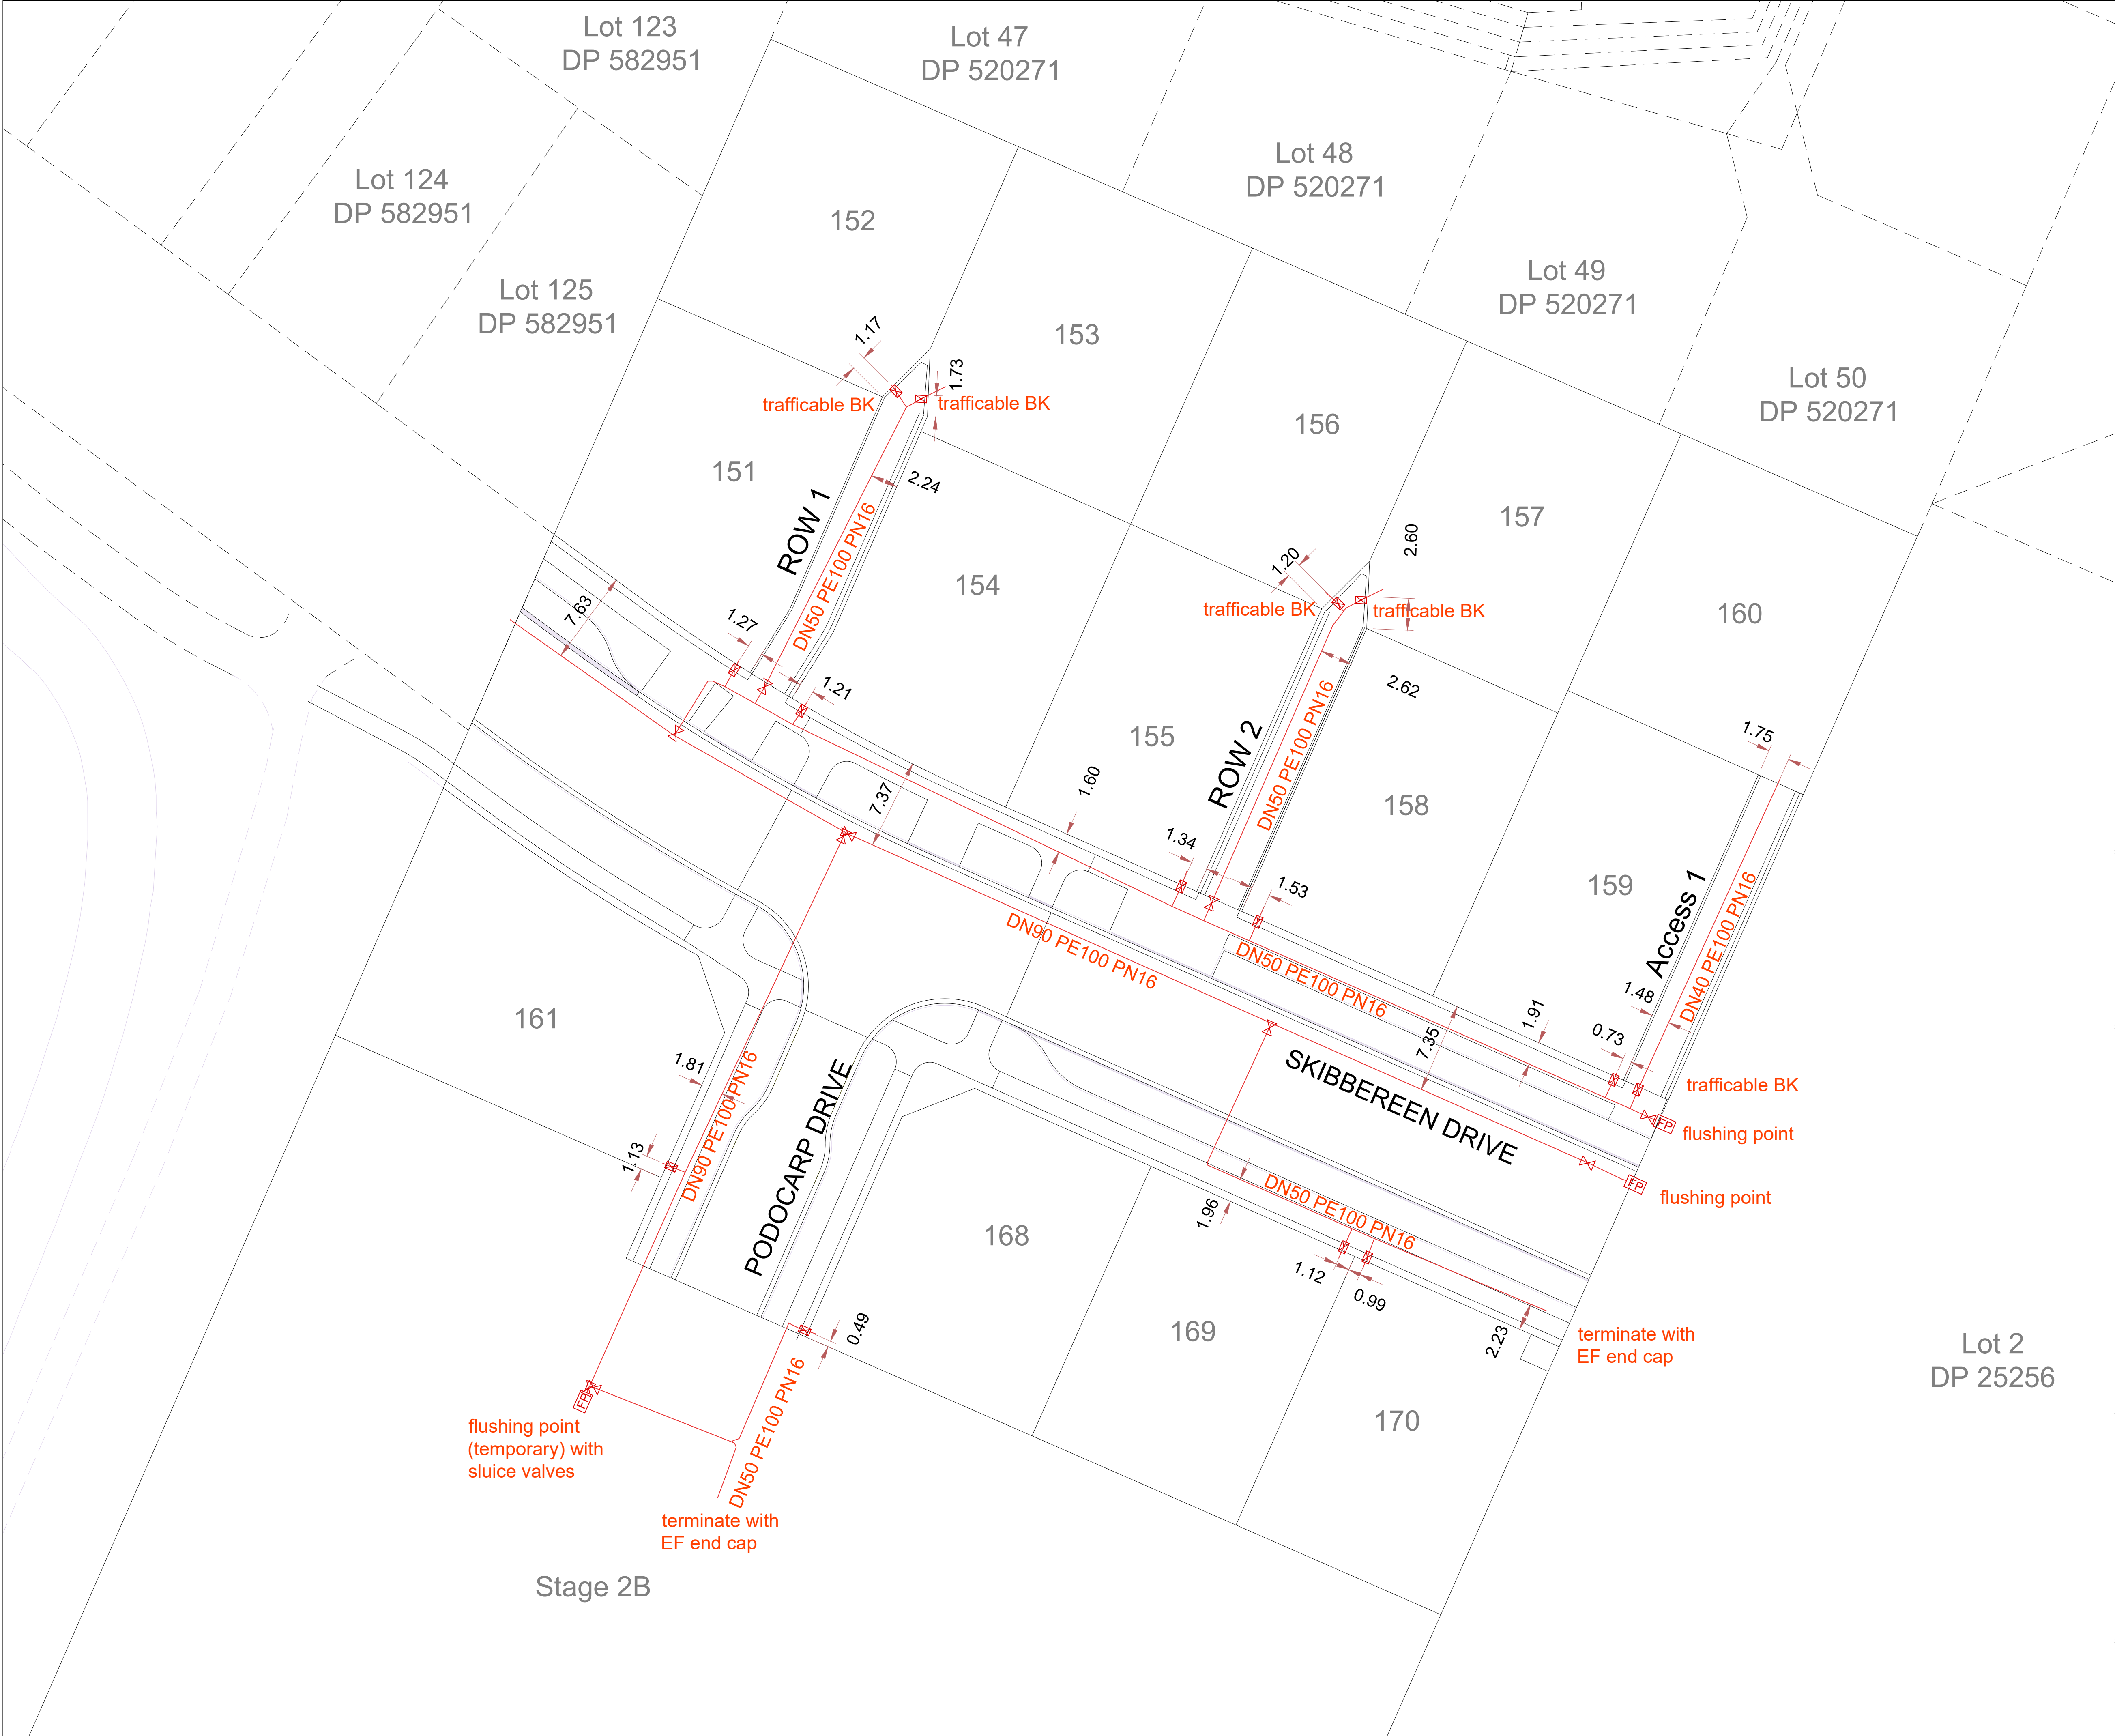

Job
RMA/2022/2524

Title
WASTEWATER ASBUILTS

A	05/24	CCC Issue	CP
issue	date	reason	approved


Disclaimer: This document shall only be reproduced in full with approval from Suburban Estates contractor to locate all existing services & verify all dimensions before commencing work

Origin of Levels BM0148, EKRR, RL22.816
Level Datum Mean sea level/Lyttelton vertical datum 1937

Projection - New Zealand Geodetic 2000 Circuit - Mount Pleasant	
Design	SM
Drawn	CP
Date	05/24
QA check	SM

**SUBURBAN ESTATES**
PREMIUM LAND DEVELOPMENTS

Phone: 03 3663729, Fax: 03 3654323 Web: www.suburbanestates.co.nz
26 Peterborough Street, Central PO Box 13 349, Christchurch 8141 New Zealand

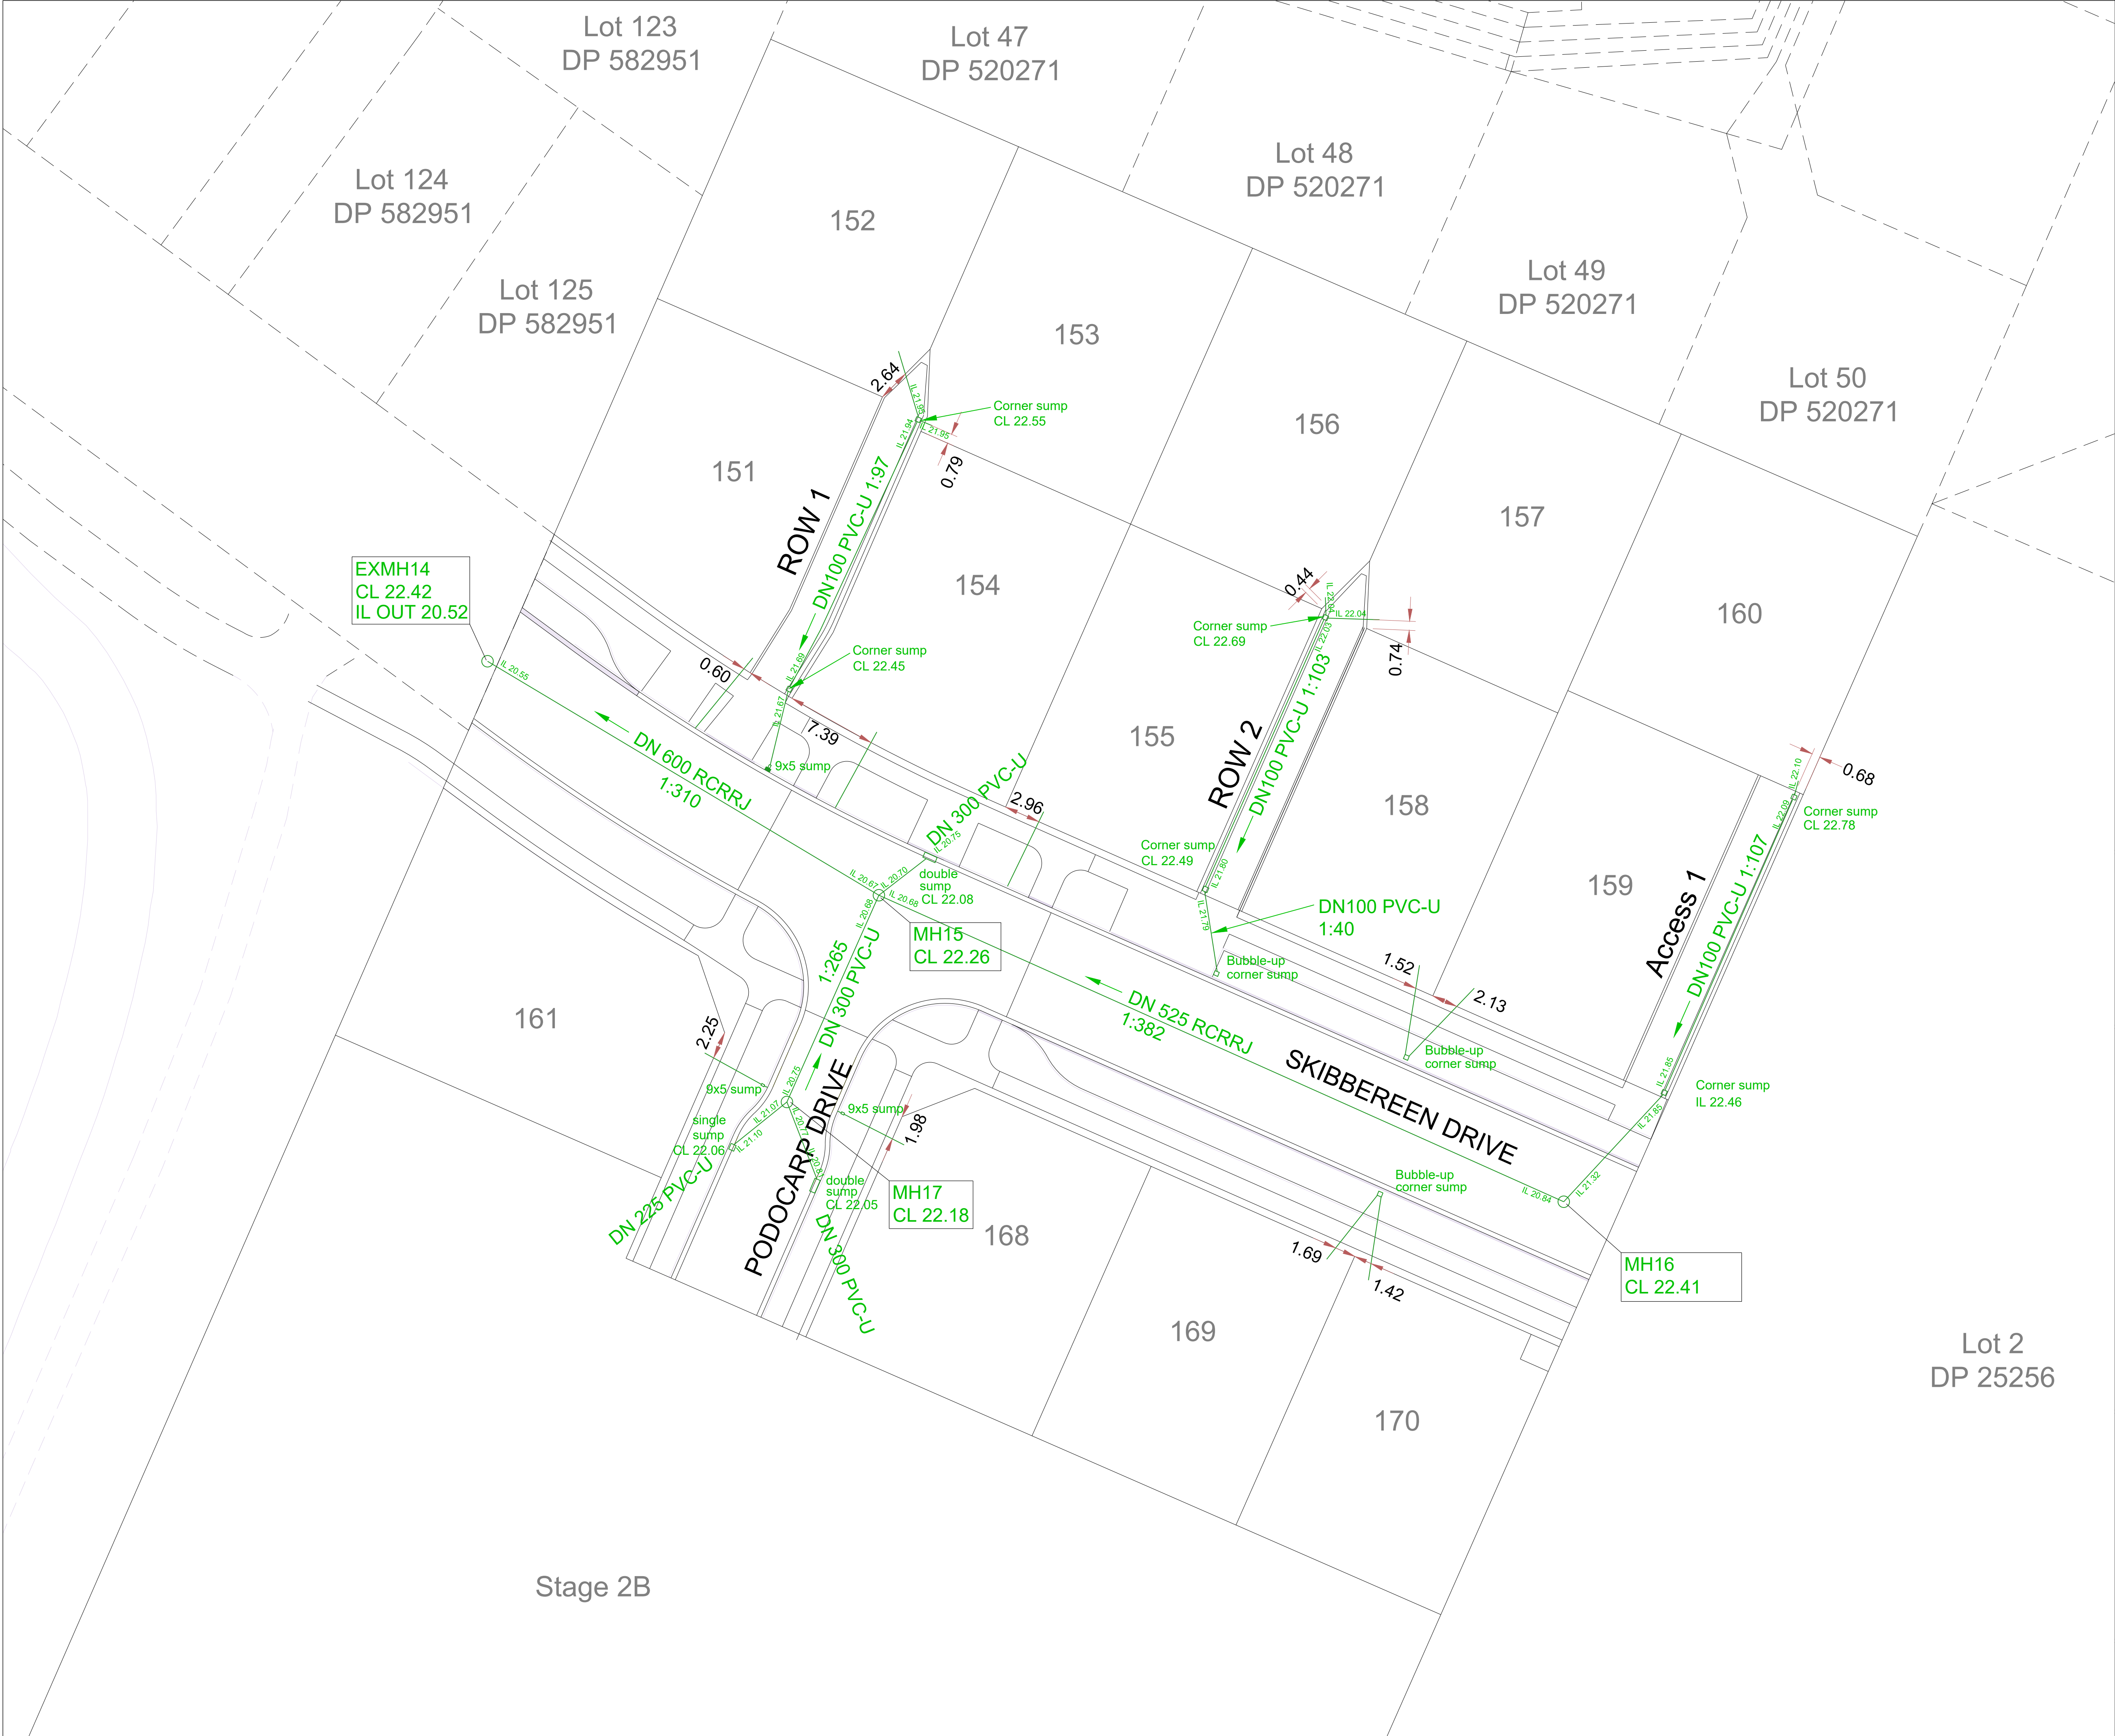

Job

RMA/2022/2524

Title

STORMWATER ASBUILTS

A	05/24	CCC Issue	CP
issue	date	reason	approved

Disclaimer: This document shall only be reproduced in full with approval from Suburban Estates contractor to locate all existing services & verify all dimensions before commencing work

Origin of Levels BM0148, EKRR, RL22.816

Level Datum Mean sea level/Lyttelton vertical datum 1937

Projection - New Zealand Geodetic 2000
Circuit - Mount Pleasant

Design	SM
Drawn	CP
Date	05/24
QA check	SM

SUBURBAN ESTATES

PREMIUM LAND DEVELOPMENTS

Phone: 03 3663729, Fax: 03 3654323 Web: www.suburbanestates.co.nz
26 Peterborough Street, Central PO Box 13 349, Christchurch 8141 New Zealand


AutoCAD ref: ASBUILTS	Scale e A3 1:1000
Sheet 2 of 4	Scale e A1 1:500

Drawing

322

Revision

A

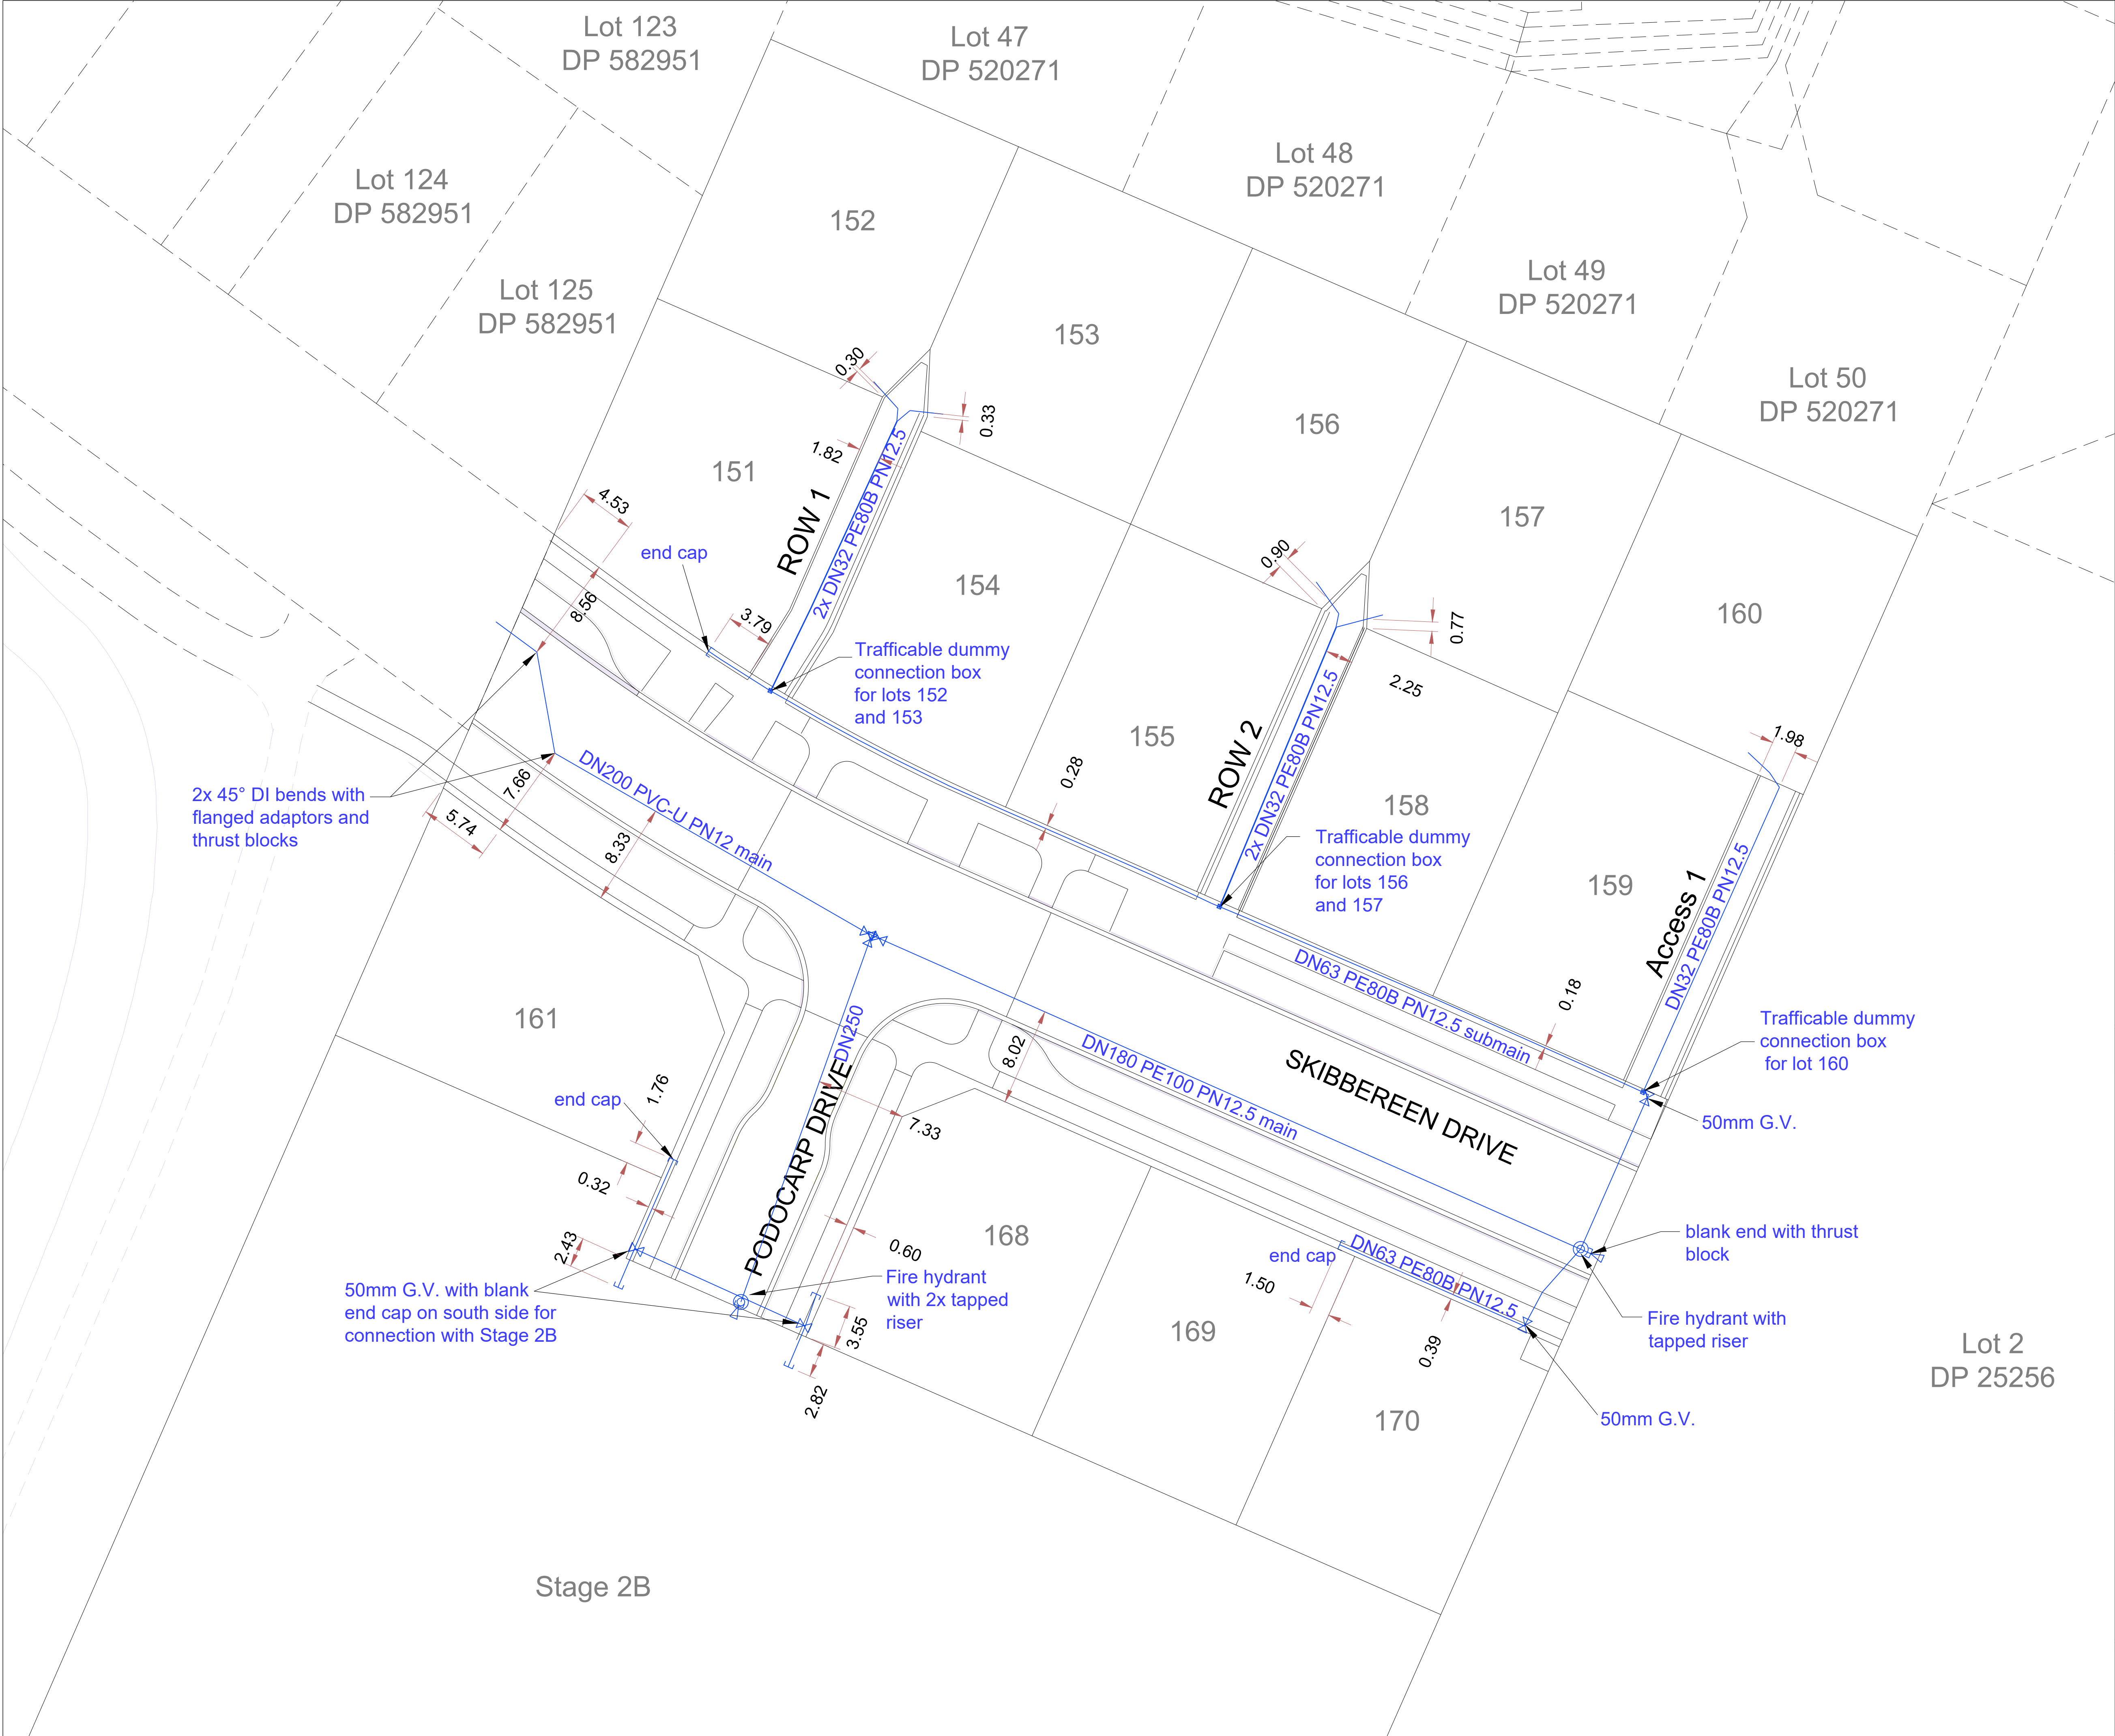

N

W

E

S

Job

RMA/2022/2524

Title

WATER SUPPLY ASBUILTS

A	05/24	CCC Issue	CP
issue	date	reason	approved

Disclaimer: This document shall only be reproduced in full with approval from Suburban Estates contractor to locate all existing services & verify all dimensions before commencing work

Origin of Levels BM0148, EKRR, RL22.816

Level Datum Mean sea level/Lyttelton vertical datum 1937

Projection - New Zealand Geodetic 2000
Circuit - Mount Pleasant

Design	SM
Drawn	CP
Date	05/24
QA check	SM

SUBURBAN

ESTATES

PREMIUM LAND DEVELOPMENTS

Phone: 03 3663729, Fax: 03 3654323 Web: www.suburbanestates.co.nz
26 Peterborough Street, Central PO Box 13 349, Christchurch 8141 New Zealand

AutoCAD ref: ASBUILTS
Sheet 3 of 4

Scale e A3 1:1000
Scale e A1 1:500

Drawing

323

Revision

A