



/ issue	/ date	/ reason	/ approved
A1	13/03/24	224 - As-builts	

AS BUILT

LEGEND:			
	Stage Boundary		
	Proposed local pressure sewer pipe with diameter and material shown.		
	Existing local pressure sewer pipe.		
	As-built sewer flushing point to CSS SD383.		
	As-built sewer boundary kit to CSS SD384.		
	As-built valve, size shown on plans		
	As-built reducer		

CAD ref: 39630.Stage 5 Sewer Asbuilts.dwg



/ issue	/ date	/ reason	/ approved
A1	13/03/25	224 - As-builts	

AS BUILT

LEGEND:

- Stage Boundary
- As-built stormwater pipe with diameter, material and gradient shown.
- Existing stormwater pipe.
- As-built stormwater manhole with diameter, cover level and invert level shown.
- Existing stormwater manhole.
- As-built single sump.
- As-built double sump.
- As-built bubble up sump.

CAD ref: 39630.Stage 5 Stormwater Asbuilts.dwg



/ issue	/ date	/ reason	/ approved
A1	28/04/25	224 - As-builts	

AS BUILT

LEGEND:	
	Site boundary
	Existing water pipe
	As-built water pipe
	Ex. FH Existing Fire Hydrant
	FH As-built Fire Hydrant as per SD402 with tapped riser
	Existing Valve (sluice or gate)
	S.V. As-built Sluice Valve with diameter shown.
	G.V. As-built 50 mm Hawle gate valve on 63 PE 808
	T.B. As-built Thrust Block
	As-built Blank End with thrust block
	B.E. As-built Blank End

CAD ref: 39630.Stage 5 Water As-Builts.dwg



DAVIS OGILVIE


ENGINEERS / SURVEYORS / PLANNERS

Davis Ogilvie & Partners Limited

Level 1, 24 Moorhouse Avenue, Addington, Christchurch 8140

Office 0800 999 333 Email hello@do.nz

www.do.nz

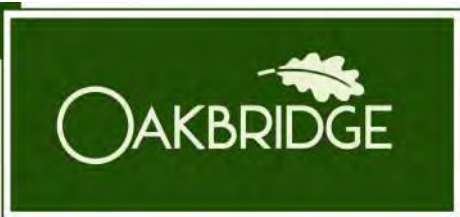

OAKBRIDGE - PRESTONS ROAD, REDWOOD
PROPOSED SUBDIVISION

AS-BUILT PLANS - STAGE 5
WATER AS-BUILTS

/ design	/ drawn	/ QA check	/ dwg
DGB	AL	IZ	AB03
/ scale @ A1	/ date	/ file	/ issue
1:500	04/25	39630	A1