


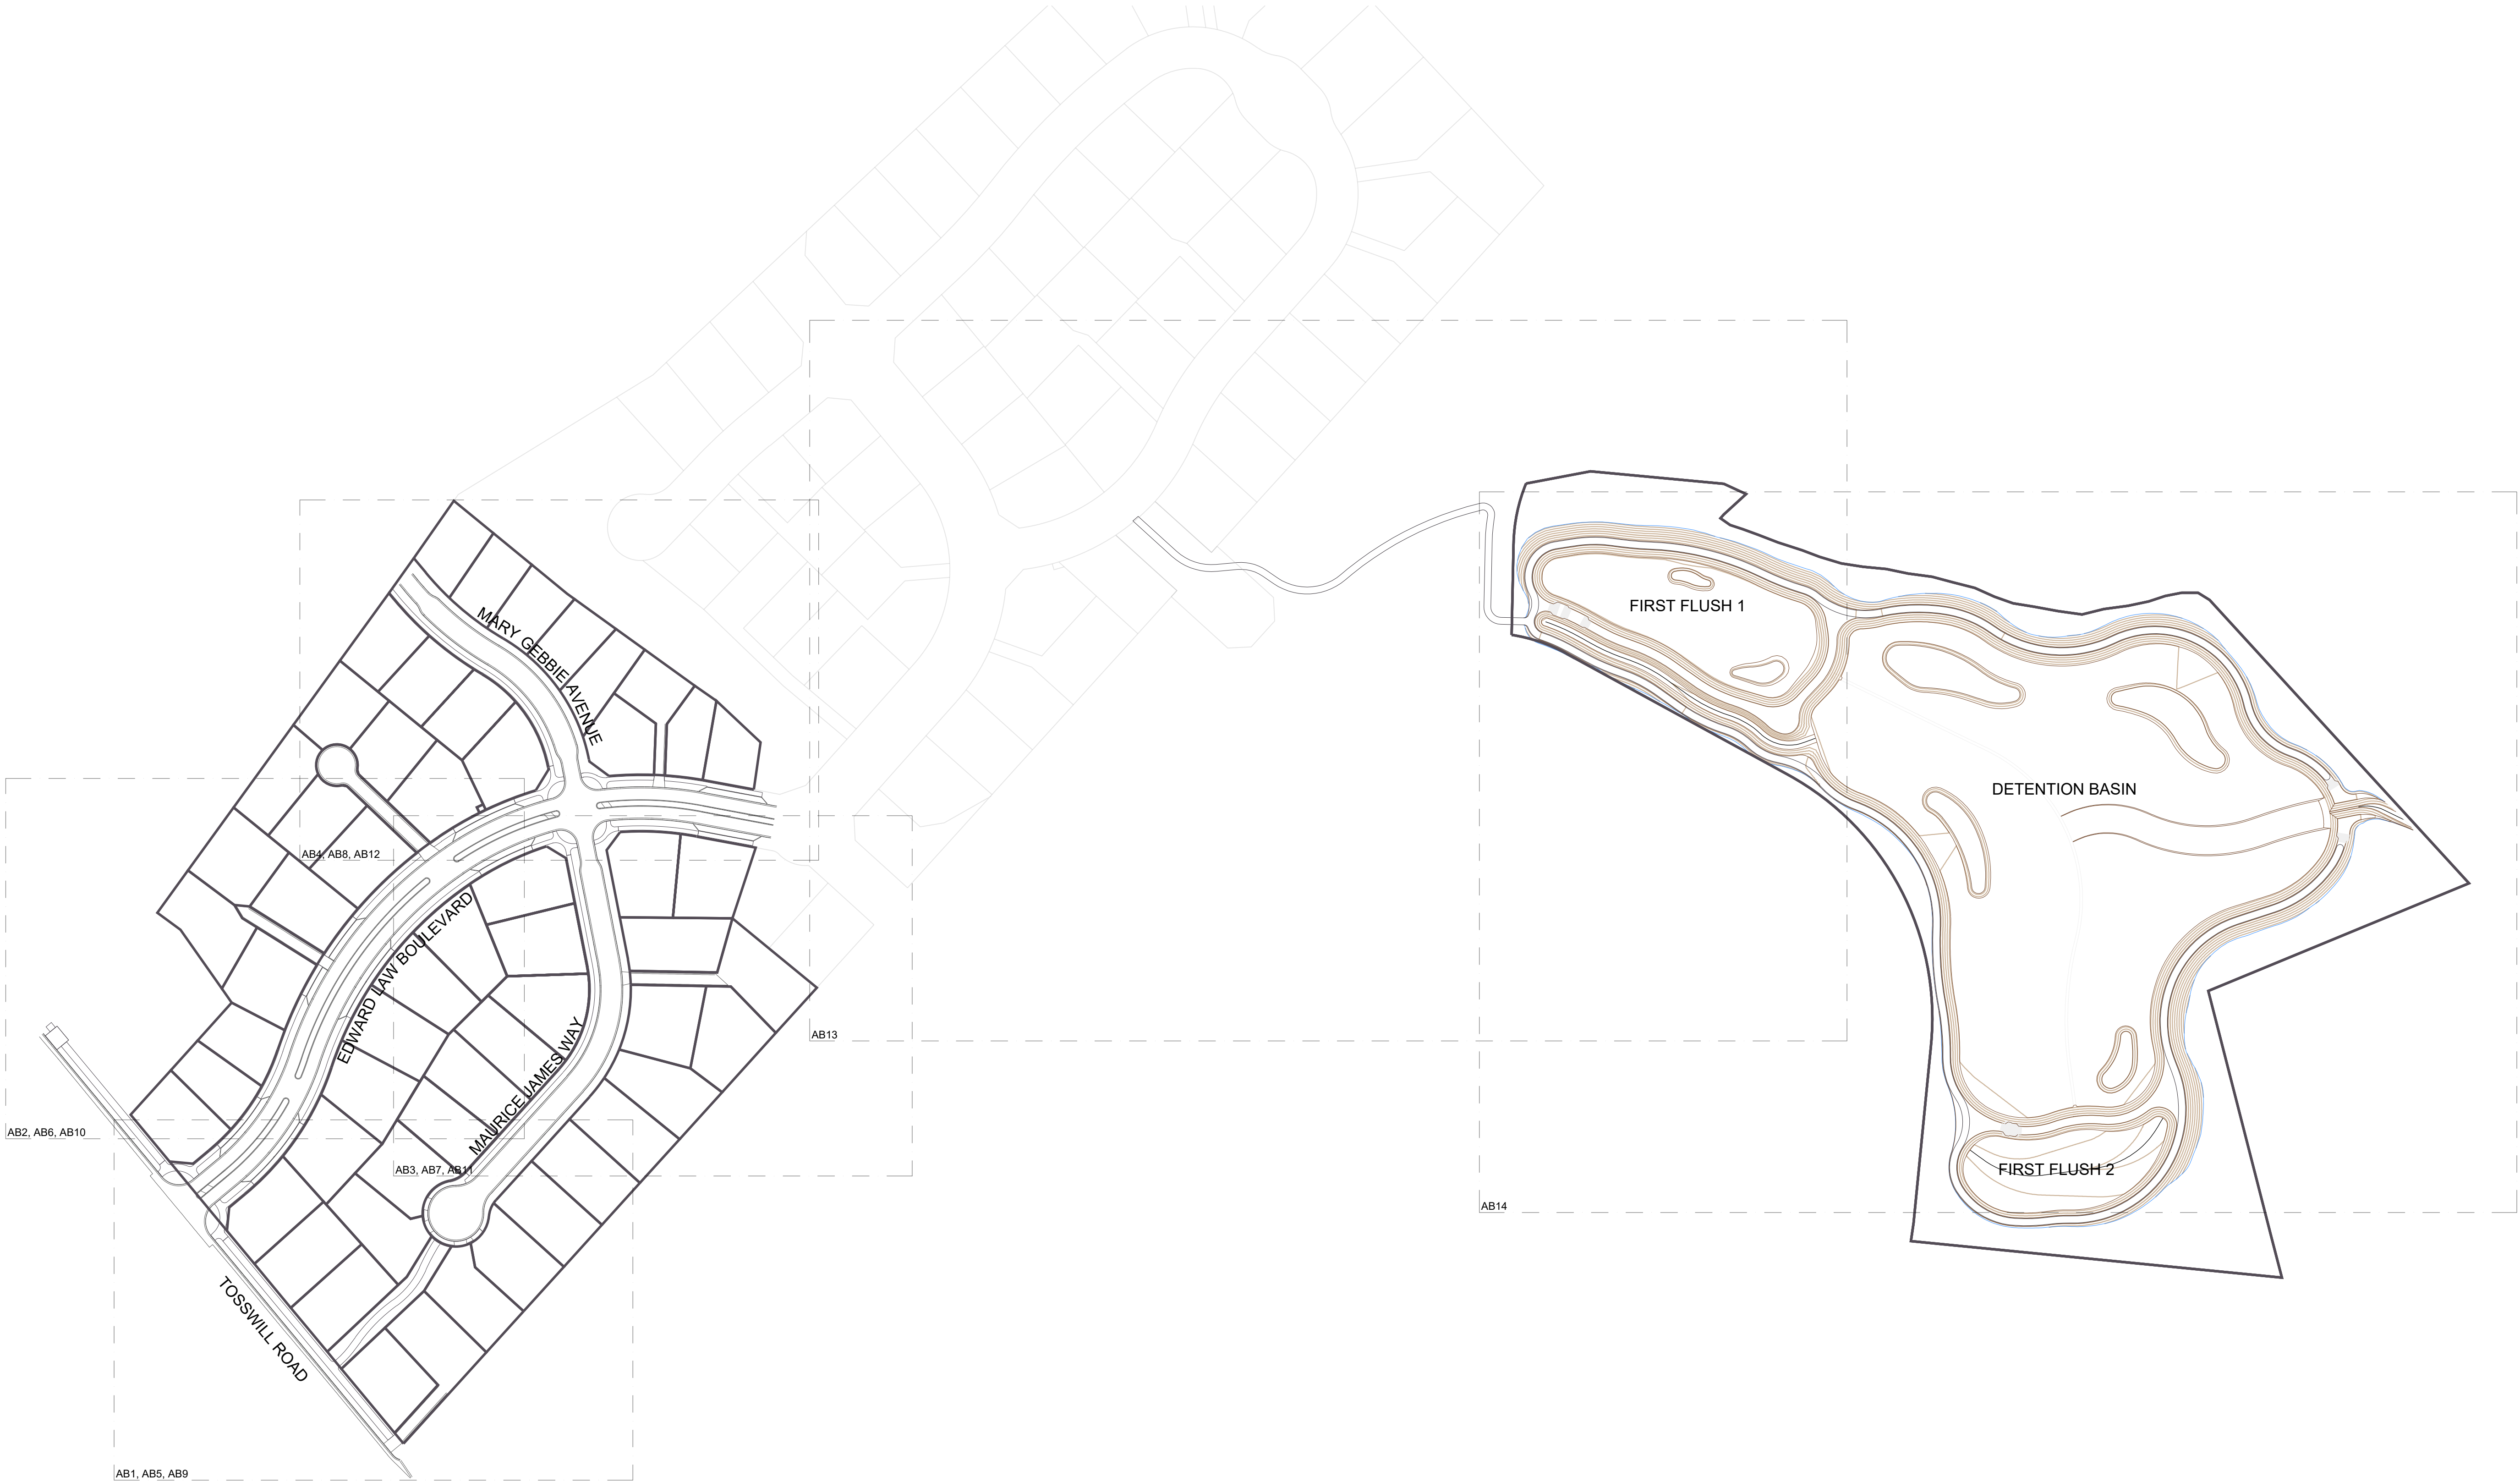

Title

PREVELLES, PREBBLETON
ASBUILT DRAWINGS - OVERALL PLAN

Origin of Levels - BM EKQ6, Capped SS, Cnr Halswell Junction Rd and Springs Rd. RL 23.311
Level Datum - Christchurch Drainage Datum

Drawn	SM	Date	03/03/21
		QA check	CP


A	03/03/21	224 Application	CP
issue	date	reason	approved

AutoCAD ref: 195533-ASBUILTS
Sheet .

Drawing **AB**

Scale @ A3 1:2500
Scale @ A1 1:1250

Revision **A**

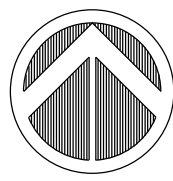



Title

**PREVELLES, PREBBLETON
SEWER ASBUILTS**

Origin of Levels - BM EKG6, Capped SS, Cnr Halswell Junction Rd and Springs Rd. RL 23.311			
Level Datum - Christchurch Drainage Datum			
Date		19/02/21	
Drawn	SM	QA check	CP

AutoCAD ref: 195533-ASBUILTS		Scale @A3 1:500	
Sheet .		Scale @A1 1:250	
Drawing AB1		Revision A	

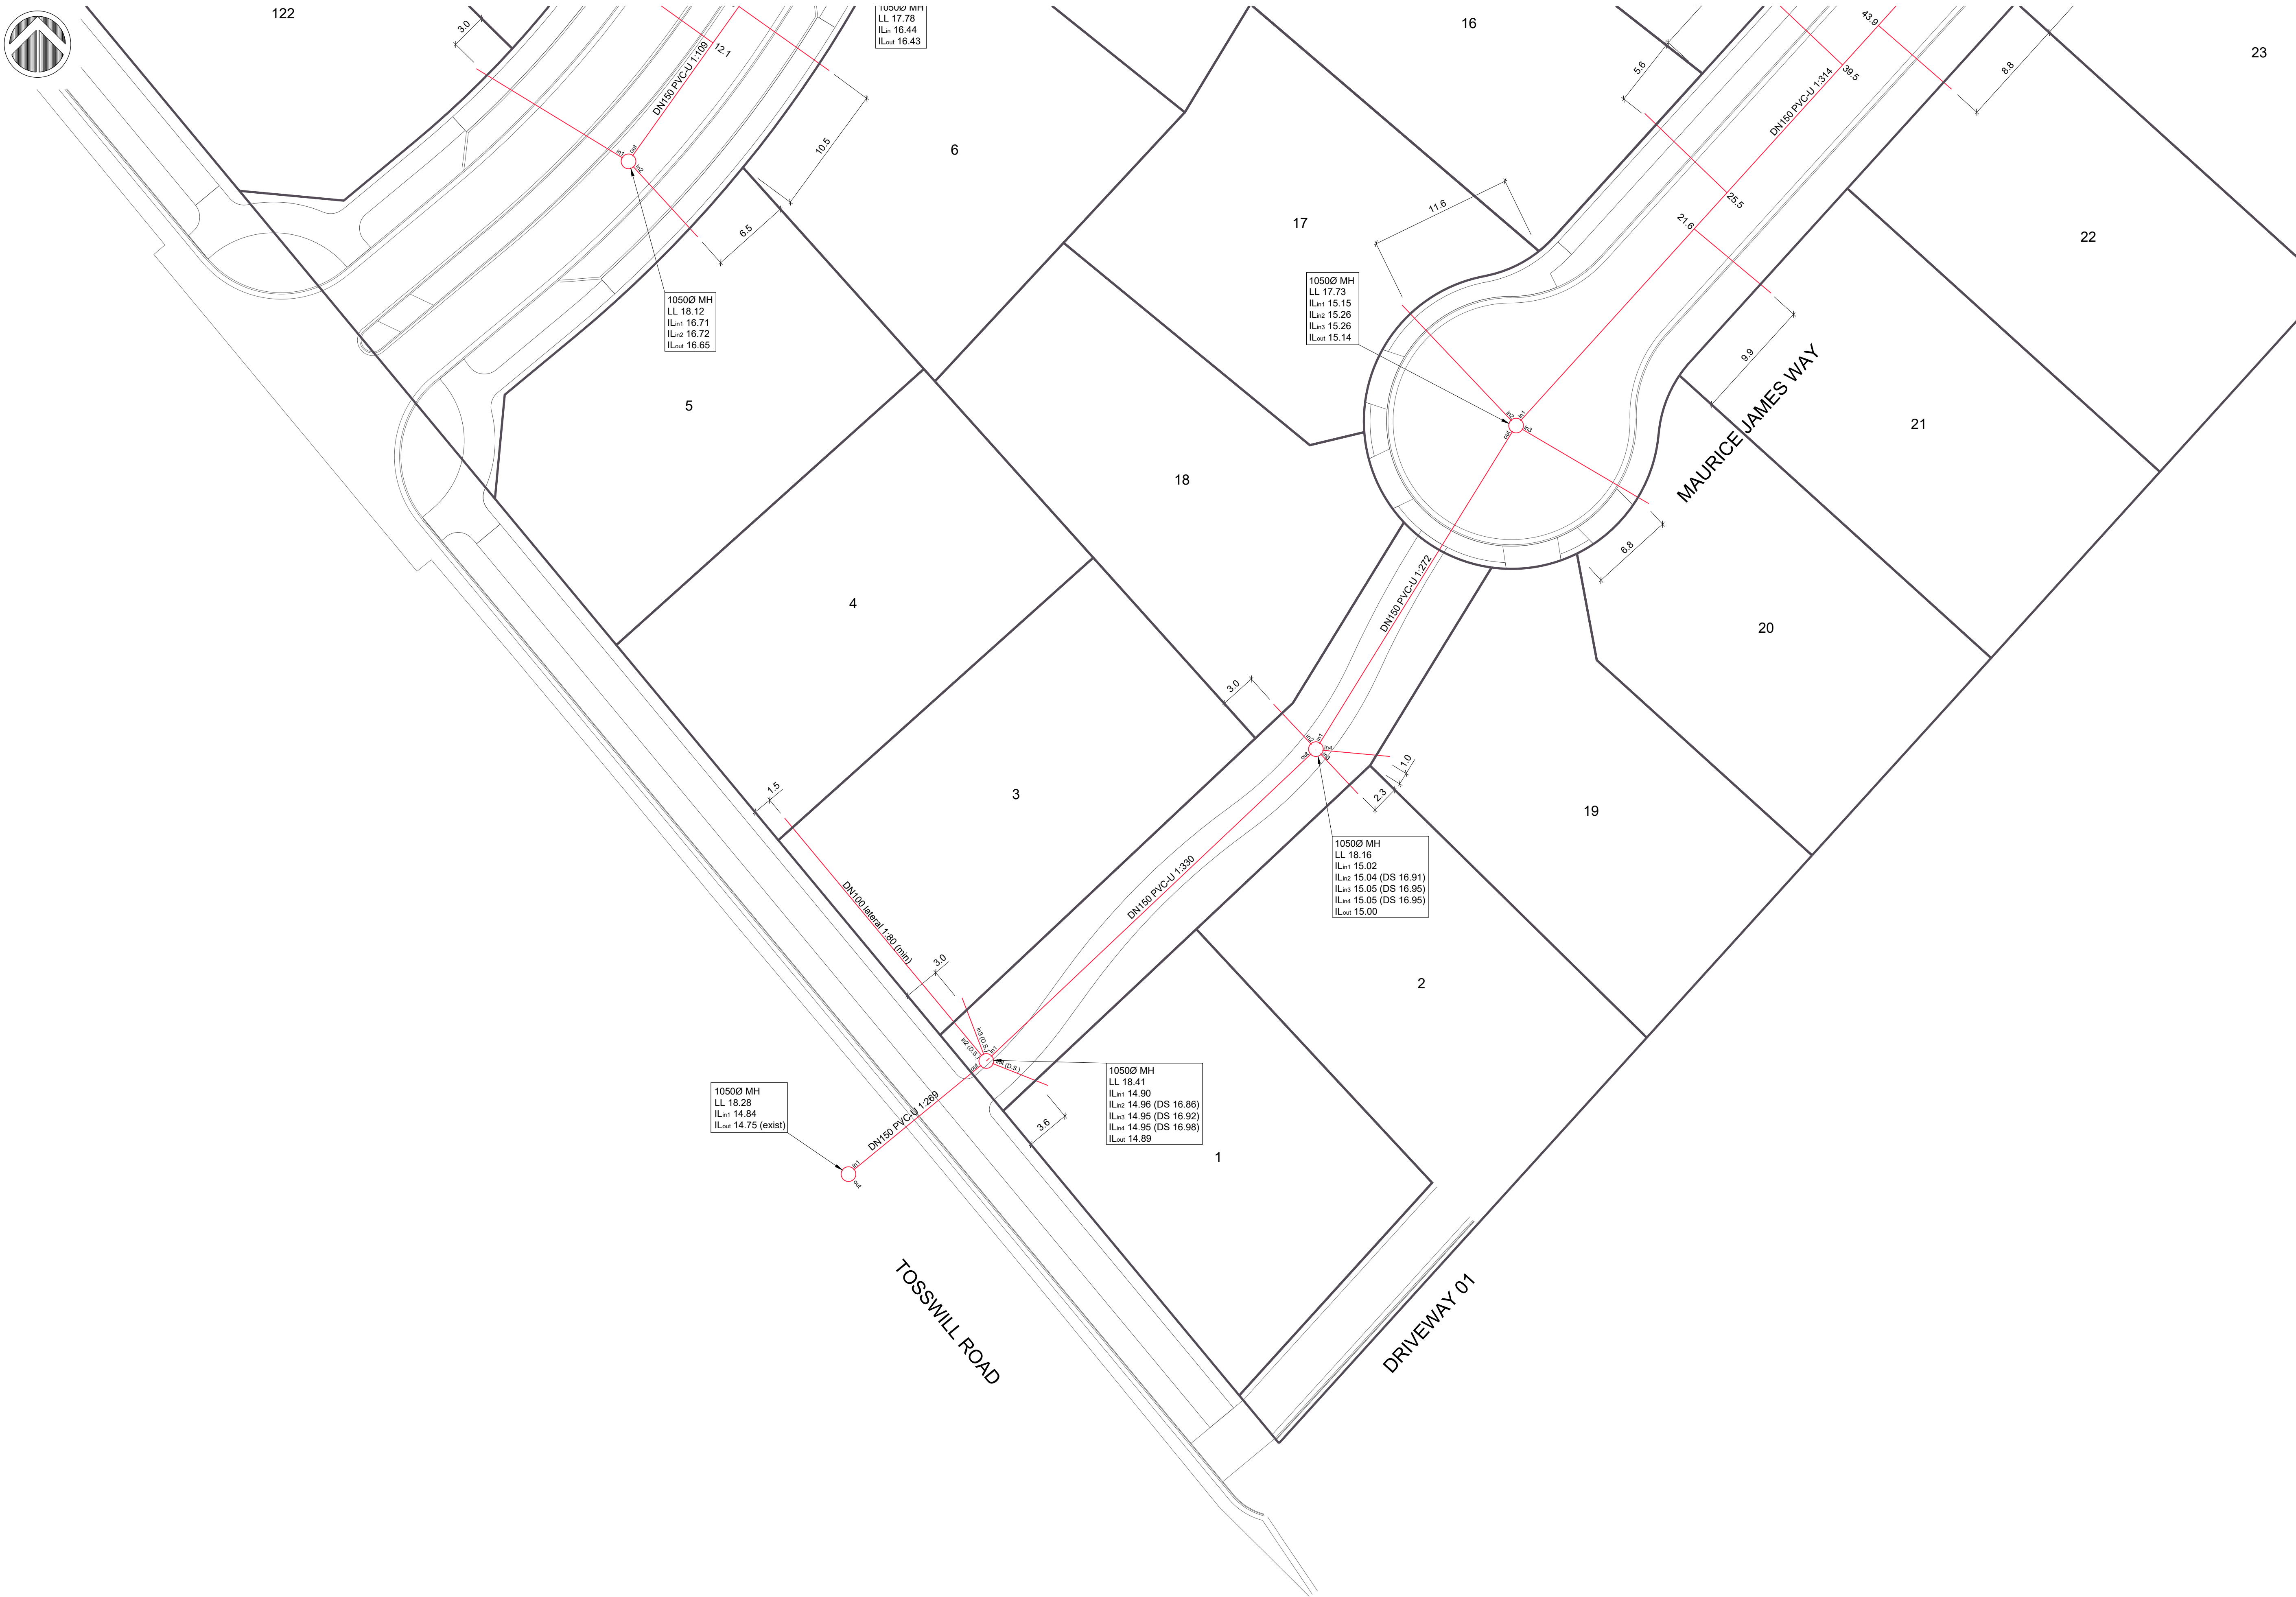

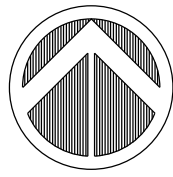

LEGEND

- Sewer pipe
- Sewer manhole
- Water supply pipe
- Water meter
- Valve
- Fire hydrant
- Thrust block
- 20MC269649 Water meter serial number
- Stormwater pipe
- Stormwater manhole (circular)
- Stormwater manhole (square)
- Single sump
- Double sump

Title				Origin of Levels - BM EKQ6, Capped SS, Cnr Halswell Junction Rd and Springs Rd. RL 23.311				AutoCAD ref: 195533-ASBUILTS				Scale @A3 1:500	
PREVELLES, PREBBLETON				Level Datum - Christchurch Drainage Datum				Sheet .		Scale @A1 1:250		Revision A	
SEWER ASBUILTS								Drawing AB2					
Drawn		SM		Date		19/02/21							
				QA check		CP							




LEGEND			
—	Sewer pipe	—	Water supply pipe
○	Sewer manhole	⊗	Water meter
⋈	Valve	⊙	Fire hydrant
⋈	Thrust block	⋈	20MC269649
—	Stormwater pipe	○	Stormwater manhole (circular)
□	Stormwater manhole (square)	■	Single sump
■	Double sump		

Title
**PREVELLES, PREBBLETON
SEWER ASBUILTS**

Origin of Levels - BM EKQ6, Capped SS, Cnr Halswell Junction Rd and Springs Rd. RL 23.311			
Level Datum - Christchurch Drainage Datum			
Drawn	SM	Date	19/02/21
		QA check	CP

AutoCAD ref: 195533-ASBUILTS	Scale @A3 1:500
Sheet .	Scale @A1 1:250
Drawing AB3	Revision A

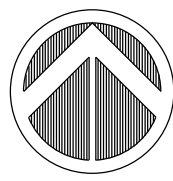

LEGEND

- Sewer pipe
- Sewer manhole
- Water supply pipe
- Water meter
- Valve
- Fire hydrant
- Thrust block
- 20MC269649 Water meter serial number
- Stormwater pipe
- Stormwater manhole (circular)
- Stormwater manhole (square)
- Single sump
- Double sump

Title

**PREVELLES, PREBBLETON
SEWER ASBUILTS**

Origin of Levels - BM EKQ6, Capped SS, Cnr Halswell Junction Rd and Springs Rd. RL 23.311
Level Datum - Christchurch Drainage Datum


Drawn	SM	Date	19/02/21
		QA check	CP

A	19/02/21	224 Application	CP
issue	date	reason	approved

AutoCAD ref: 195533-ASBUILTS
Sheet .

Drawing **AB4**
Scale @A3 1:500
Scale @A1 1:250

Revision **A**

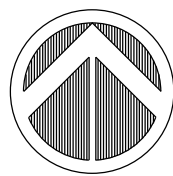

Title

PREVELLES, PREBBLETON WATER SUPPLY ASBUILTS


Origin of Levels - BM EKG6, Capped SS, Cnr Halswell Junction Rd and Springs Rd. RL 23.311			
Level Datum - Christchurch Drainage Datum			
Drawn	SM	Date	19/02/21
		QA check	CP

A	19/02/21	224 Application	CP
issue	date	reason	approved

AutoCAD ref: 195533-ASBUILTS		Scale @A3	1:500
Sheet .		Scale @A1	1:250
Drawing AB5		Revision A	

LEGEND

- Sewer pipe
- Sewer manhole
- Water supply pipe
- Water meter
- Valve
- Fire hydrant
- Thrust block
- 20MC269649 Water meter serial number
- Stormwater pipe
- Stormwater manhole (circular)
- Stormwater manhole (square)
- Single sump
- Double sump

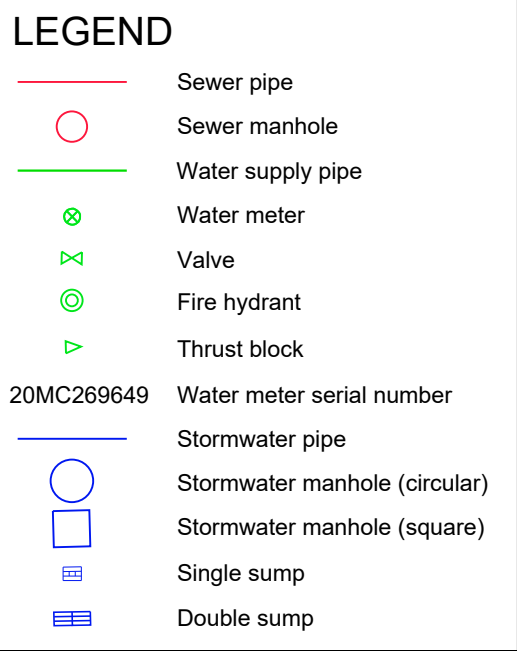




Origin of Levels - BM EKKQ6, Capped SS, Cnr Halswell Junction Rd and Springs Rd. RL 23.311

Level Datum - Christchurch Drainage Datum

		Date	19/02/21
Drawn	SM	QA check	CP

Scale @ A3 1:500
Scale @ A1 1:250

Revision **A**

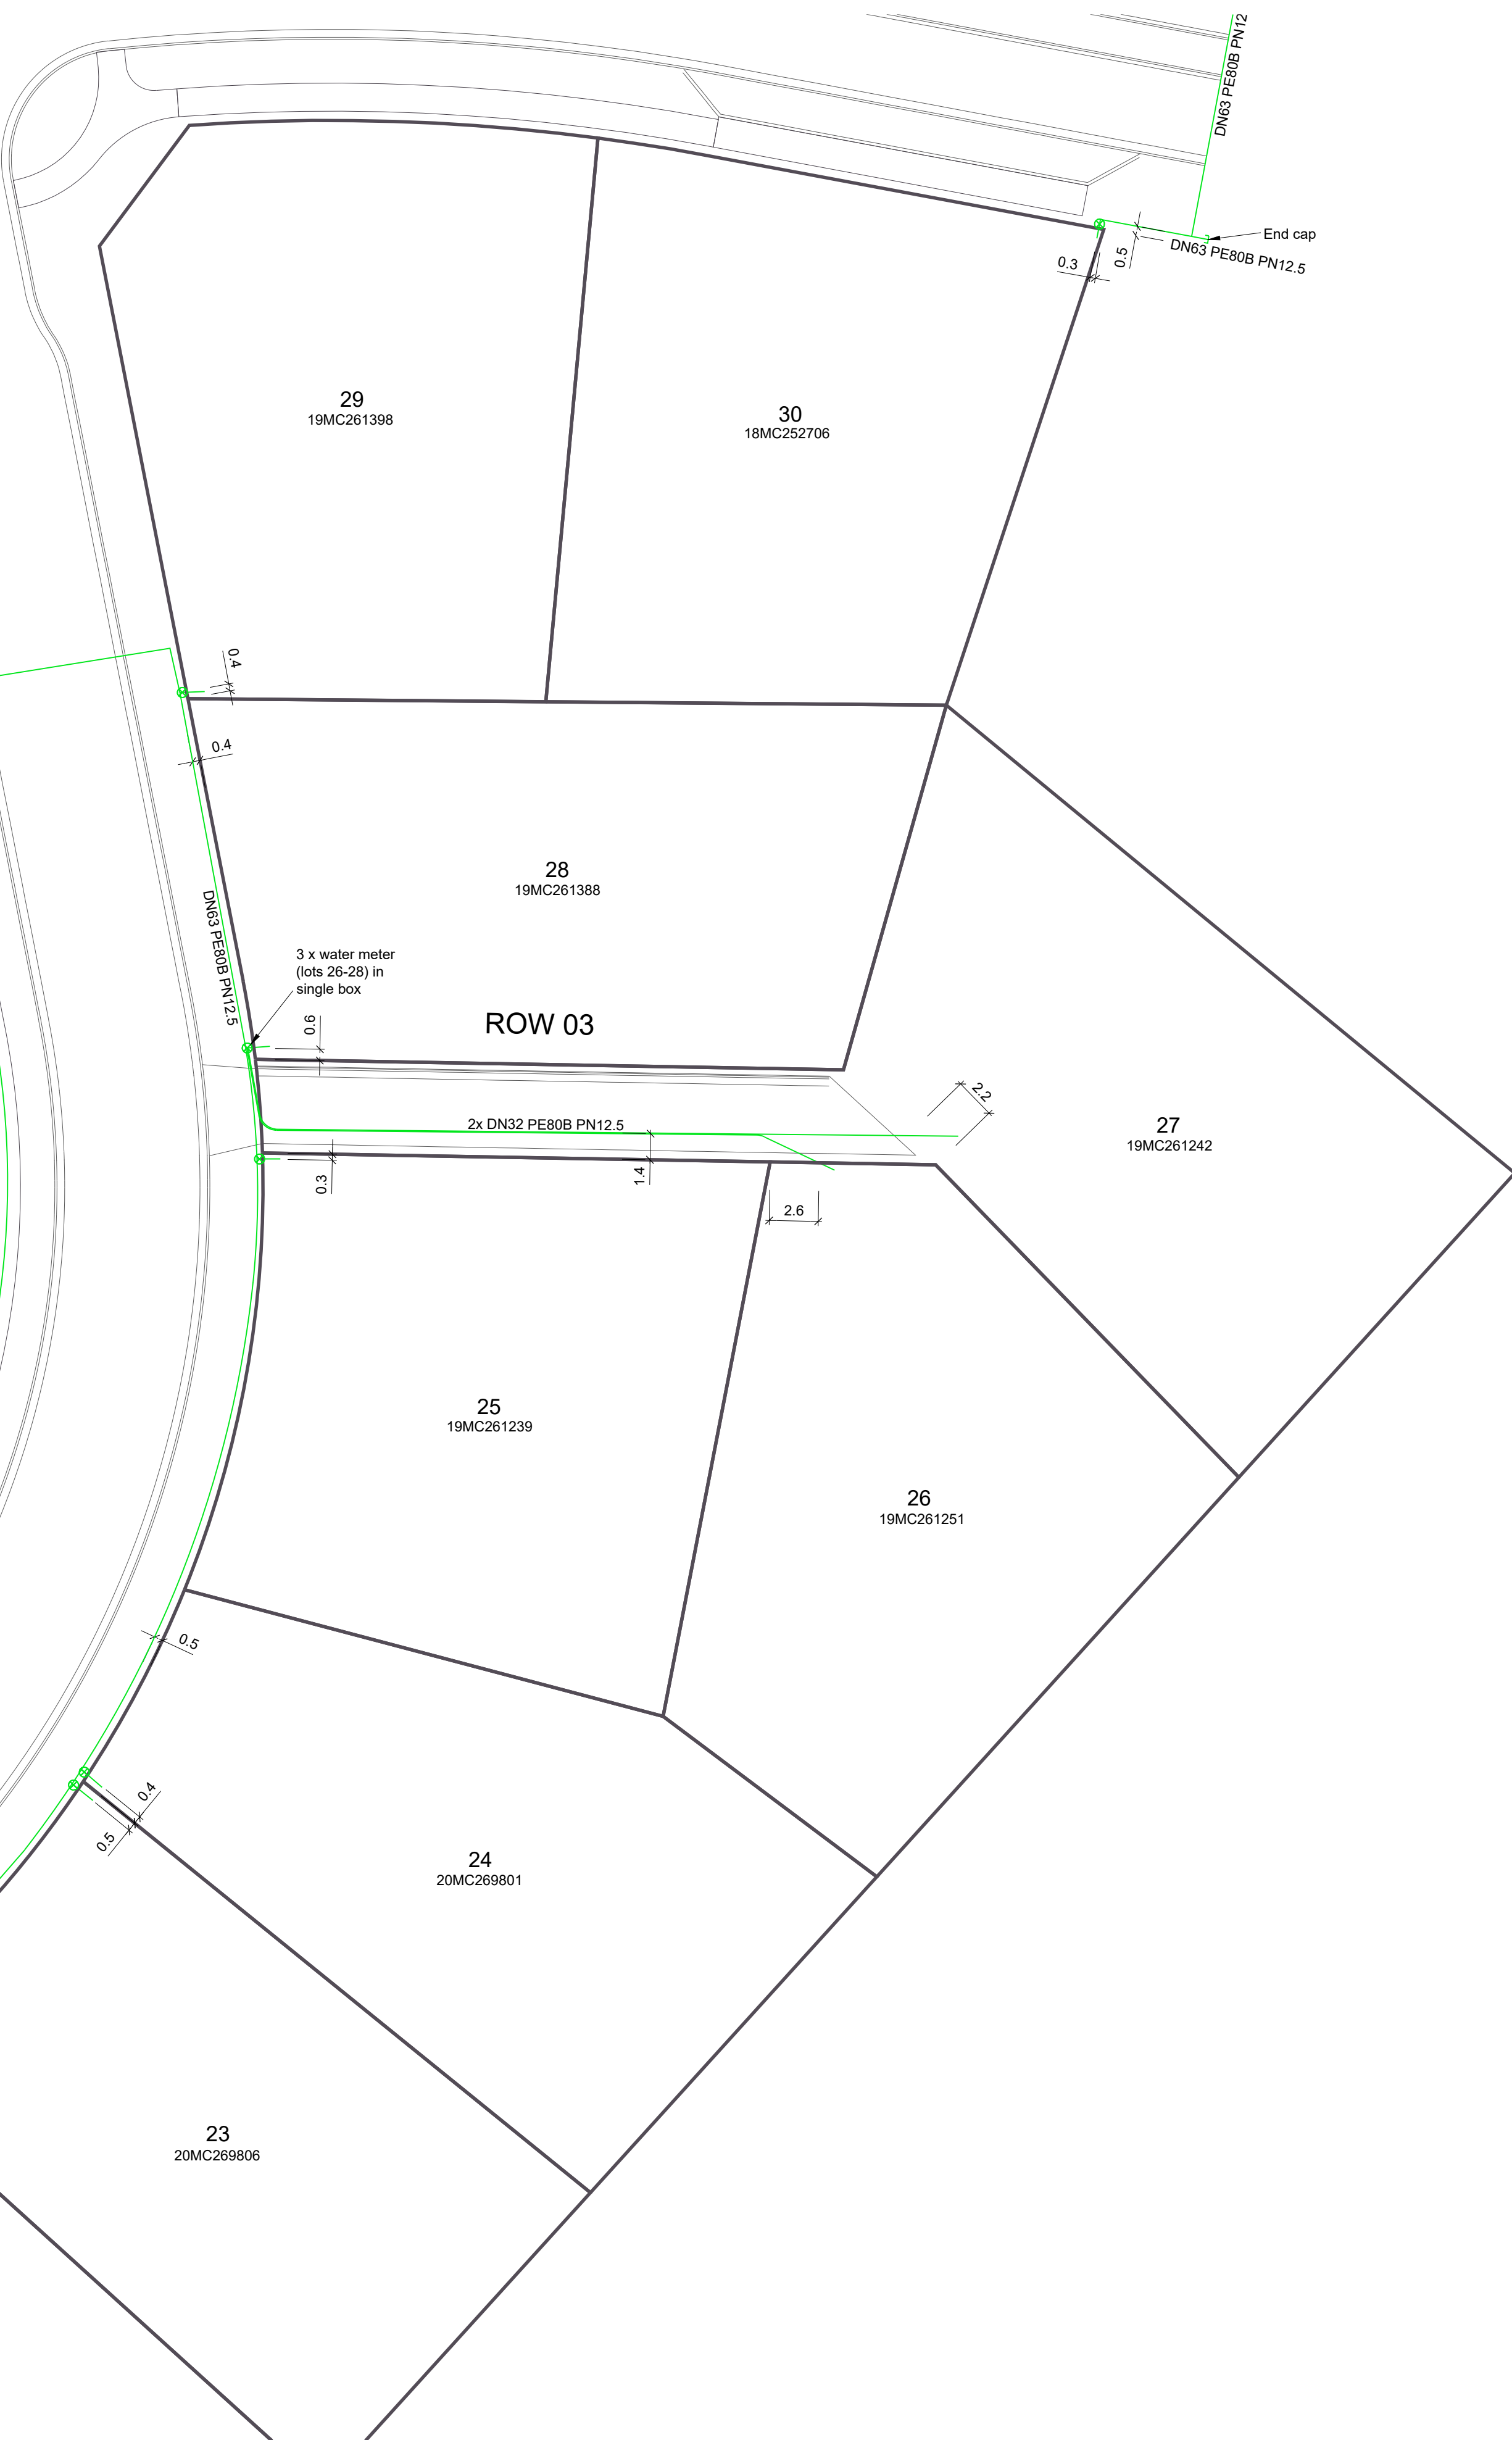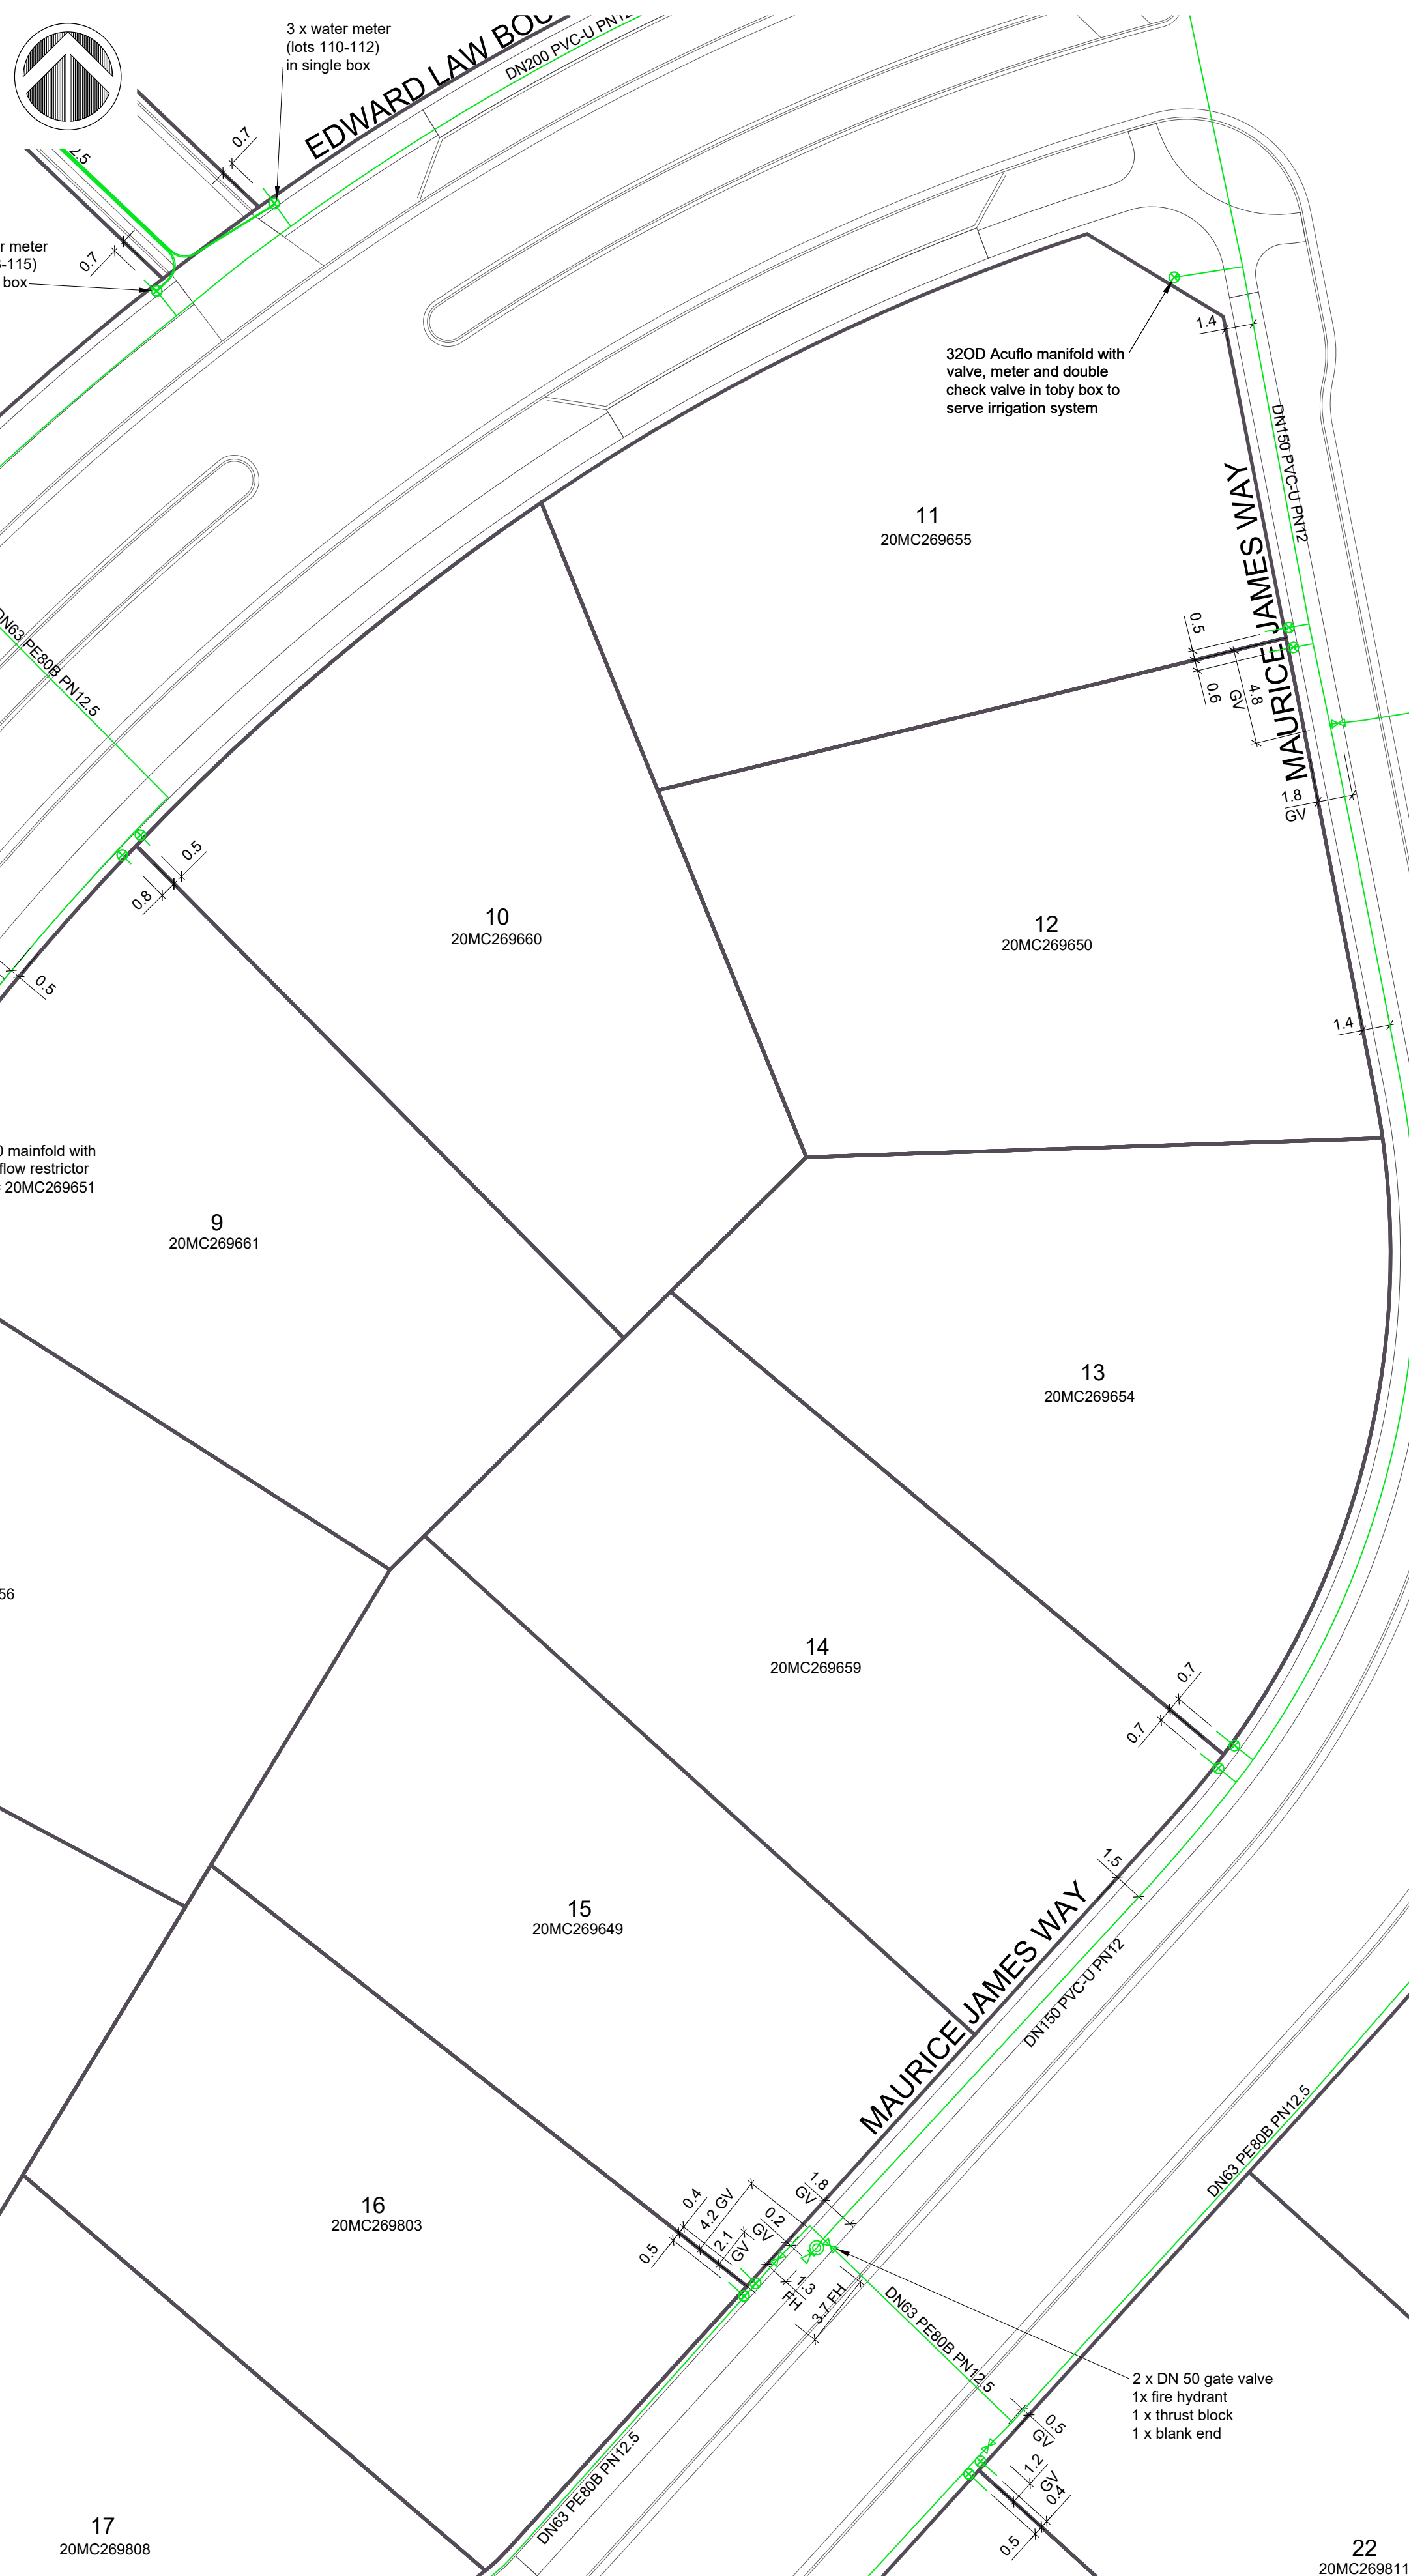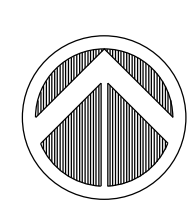

Title

PREVELLES, PREBBLETON WATER SUPPLY ASBUILTS

Origin of Levels - BM EKQ6, Capped SS, Cnr Halswell Junction Rd and Springs Rd. RL 23.311			
Level Datum - Christchurch Drainage Datum			
Drawn	SM	Date	19/02/21
		QA check	CP

A	19/02/21	224 Application	CP
issue	date	reason	approved

AutoCAD ref: 195533-ASBUILTS
Sheet .

Drawing **AB7**

Scale @A3 1:500
Scale @A1 1:250

Revision **A**

LEGEND

Sewer pipe

Sewer manhole

Water supply pipe

Water meter

Valve

Fire hydrant

Thrust block

20MC269649 Water meter serial number

Stormwater pipe

Stormwater manhole (circular)

Stormwater manhole (square)

Single sump

Double sump



LEGEND

- Sewer pipe
- Sewer manhole
- Water supply pipe
- Water meter
- Valve
- Fire hydrant
- Thrust block
- 20MC269649 Water meter serial number
- Stormwater pipe
- Stormwater manhole (circular)
- Stormwater manhole (square)
- Single sump
- Double sump

A	19/02/21	224 Application		CP
issue	date	reason		approved
AutoCAD ref: 195533-ASBUILTS				
Sheet .				
Drawing		Scale @A3 1:500		Scale @A1 1:250
		Revision		A

Title

**PREVELLES, PREBBLETON
WATER SUPPLY ASBUILTS**

Origin of Levels - BM EKQ6, Capped SS, Cnr Halswell Junction Rd and Springs Rd. RL 23.311			
Level Datum - Christchurch Drainage Datum			
	Date	19/02/21	
Drawn	SM	QA check	CP



LEGEND

Sewer pipe

Sewer manhole

Water supply pipe

Water meter

Valve

Fire hydrant

Thrust block

20MC269649

Water meter serial number

Stormwater pipe

Stormwater manhole (circular)

Stormwater manhole (square)

Single sump

Double sump

A	19/02/21	224 Application	CP
issue	date	reason	approved

AutoCAD ref: 195533-ASBUILTS

Sheet .

Scale @A3 1:500

Scale @A1 1:250



Drawing

AB9

Revision

A

TitlePREVELLES, PREBBLETON STORMWATER ASBUILTS			
Origin of Levels - BM EKQ6, Capped SS, Cnr Halswell Junction Rd and Springs Rd. RL 23.311 Level Datum - Lyttelton 1937			
Drawn	SM	Date	19/02/21
		QA check	CP

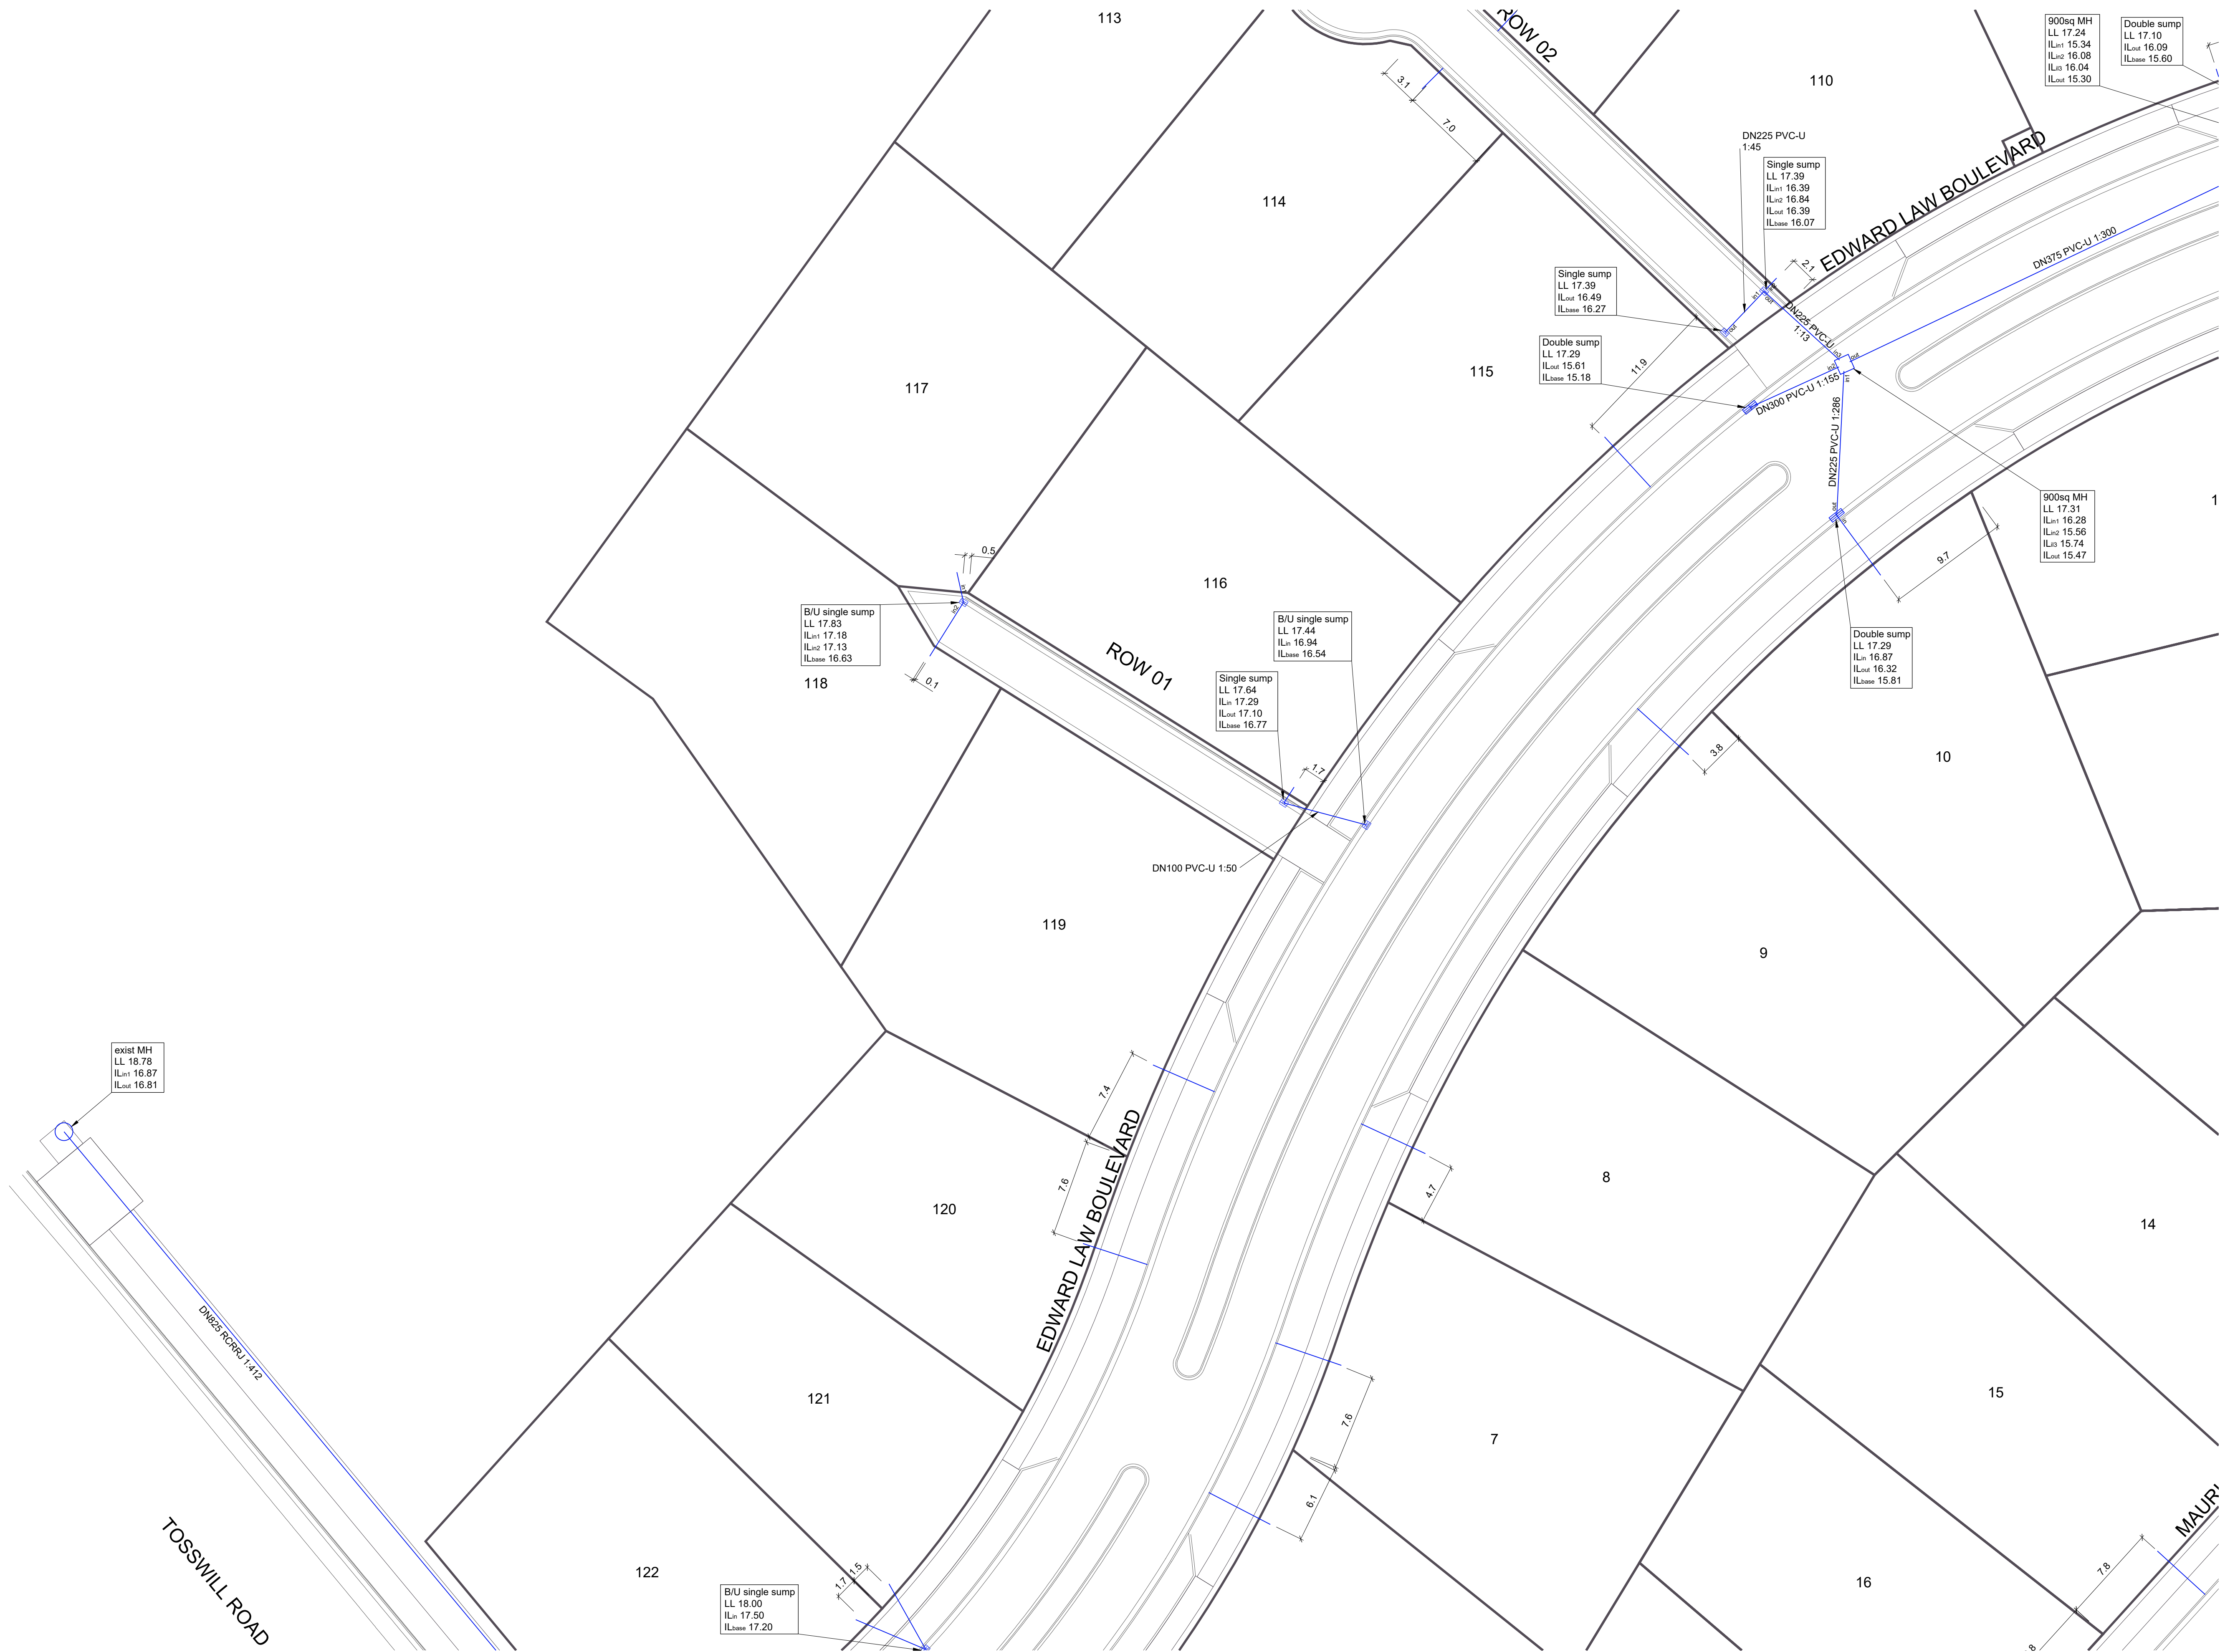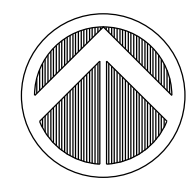

LEGEND

- Sewer pipe
- Sewer manhole
- Water supply pipe
- Water meter
- Valve
- Fire hydrant
- Thrust block
- 20MC269649 Water meter serial number
- Stormwater pipe
- Stormwater manhole (circular)
- Stormwater manhole (square)
- Single sump
- Double sump

A	19/02/21	224 Application		CP
issue	date	reason		approved

Title

PREVELLES, PREBBLETON STORMWATER ASBUILTS

Origin of Levels - BM EKQ6, Capped SS, Cnr Halswell Junction Rd and Springs Rd. RL 23.311
Level Datum - Lyttelton 1937


Drawn	SM	Date	19/02/21
		QA check	CP

AutoCAD ref: 195533-ASBUILTS
Sheet .

Scale @A3 1:500
Scale @A1 1:250

Drawing **AB10**

Revision **A**

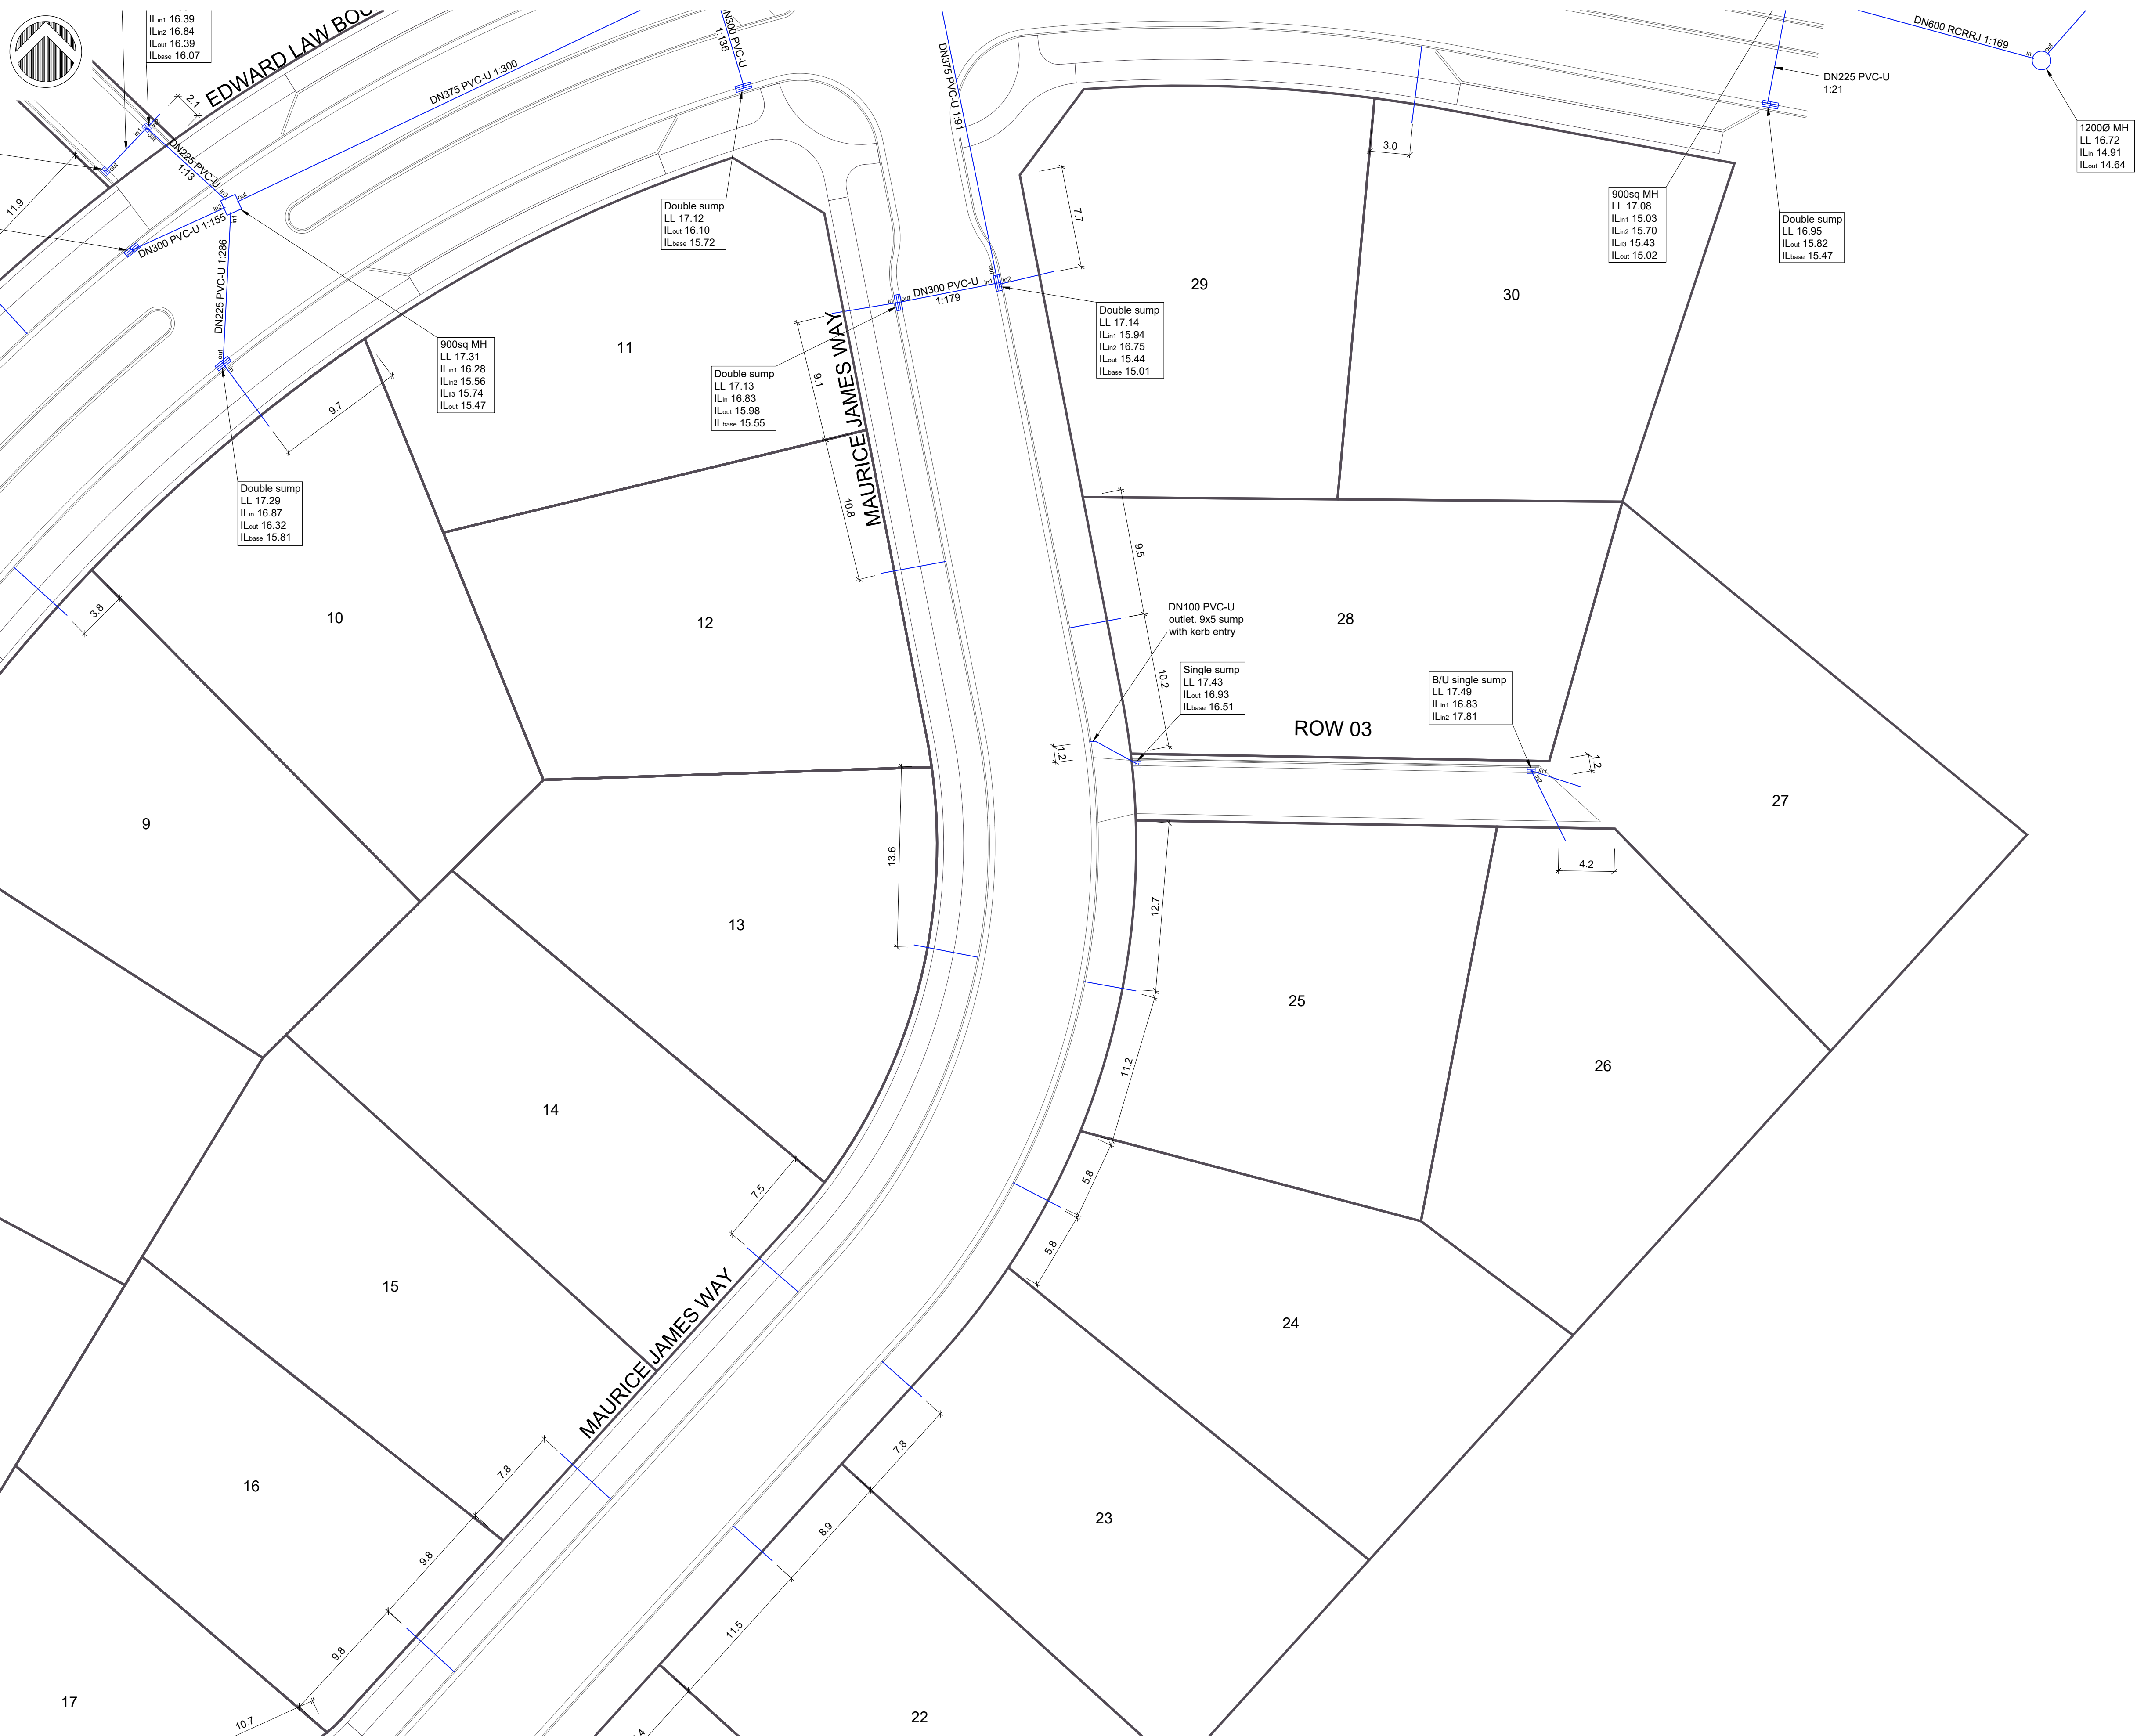


PREVELLES, PREBBLETON
STORMWATER ASBuILTS

Origin of Levels - BM EKG6, Capped SS, Cnr Halswell Junction Rd and Springs Rd. RL 23.311			
Level Datum - Lyttelton 1937			
Date		19/02/21	
Drawn	SM	QA check	CP

AutoCAD ref: 195533-ASBuILTS	Scale @A3 1:500
Sheet .	Scale @A1 1:250
Drawing AB11	Revision A

issue	date	reason	approved
A	19/02/21	224 Application	CP

LEGEND	
	Sewer pipe
	Sewer manhole
	Water supply pipe
	Water meter
	Valve
	Fire hydrant
	Thrust block
20MC269649	Water meter serial number
	Stormwater pipe
	Stormwater manhole (circular)
	Stormwater manhole (square)
	Single sump
	Double sump

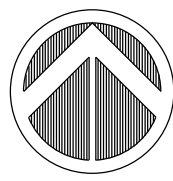

LEGEND

- Sewer pipe
- Sewer manhole
- Water supply pipe
- Water meter
- Valve
- Fire hydrant
- Thrust block
- 20MC269649 Water meter serial number
- Stormwater pipe
- Stormwater manhole (circular)
- Stormwater manhole (square)
- Single sump
- Double sump

A	19/02/21	224 Application	CP
B	01/03/21	Additional pipe labels	CP
issue	date	reason	approved

AutoCAD ref: 195533-ASBUILTS
Sheet .
Drawing **AB12**



Scale @ A3 1:500
Scale @ A1 1:250
Revision **B**


Title

**PREVELLES, PREBBLETON
STORMWATER ASBUILTS**

Origin of Levels - BM EKQ6, Capped SS, Cnr Halswell Junction Rd and Springs Rd. RL 23.311
Level Datum - Lyttelton 1937

Drawn	SM	Date	19/02/21
		QA check	CP

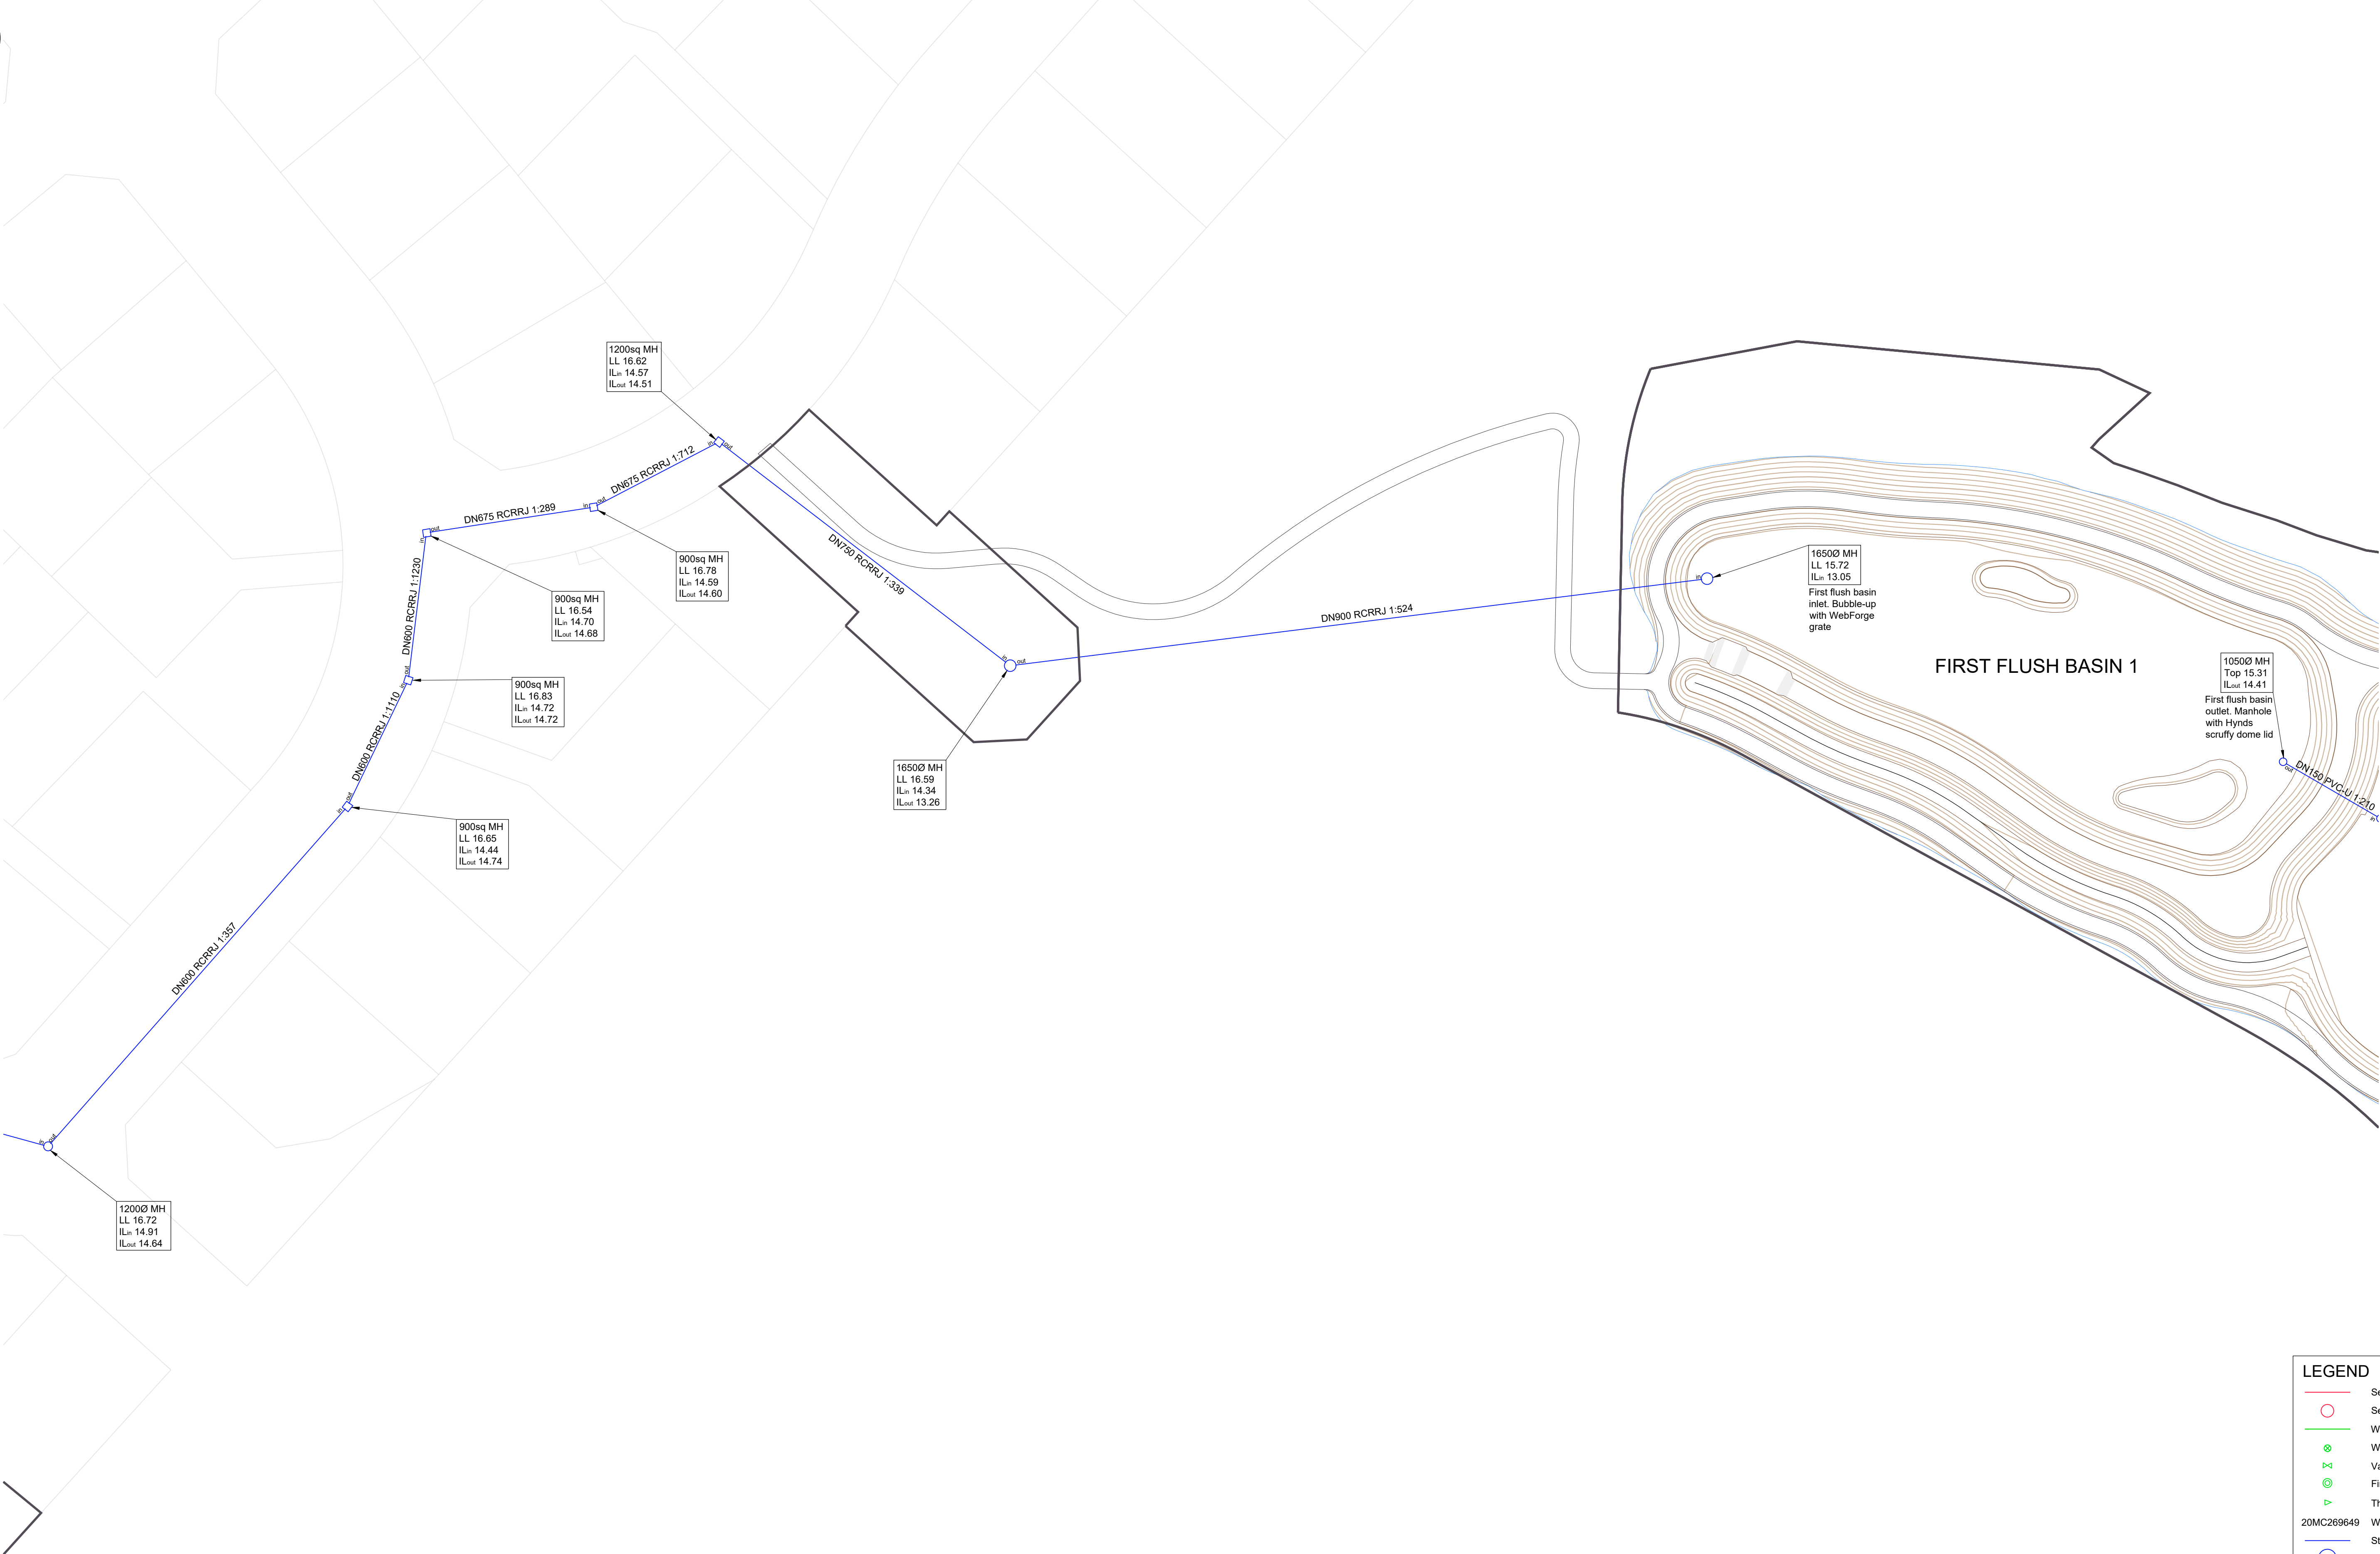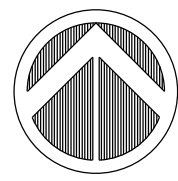

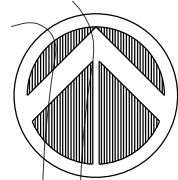


LEGEND

- Sewer pipe
- Sewer manhole
- Water supply pipe
- Water meter
- Valve
- Fire hydrant
- Thrust block
- 20MC269649
- Water meter serial number
- Stormwater pipe
- Stormwater manhole (circular)
- Stormwater manhole (square)
- Single sump
- Double sump

Title		PREVELLES, PREBBLETON STORMWATER ASBuILTS		Origin of Levels - BM EKQ6, Capped SS, Cnr Halswell Junction Rd and Springs Rd. RL 23.311 Level Datum - Lyttelton 1937	
				Date 19/02/21 QA check CP	
				Scale @A3 1:1000 Scale @A1 1:500	
				Revision B	

A	19/02/21	224 Application	CP
B	02/03/21	QA amendments. Final issue	CP
issue	date	reason	approved

AutoCAD ref: 195533-ASBuILTS		Drawing AB14	
Sheet .		Revision B	

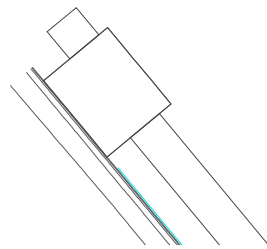

LEGEND
DN32 PE irrigation

Title
**PREVELLES, PREBBLETON
IRRIGATION ASBUILTS**

Origin of Levels - BM EK06, Capped SS, Cnr Halswell Junction Rd and Springs Rd. RL 23.311
Level Datum - Lyttelton 1937

Drawn	SM	Date	03/03/21
		QA check	CP



A	03/03/21	224 Application	CP
issue	date	reason	approved

AutoCAD ref: 195533-ASBUILTS
Sheet .

Drawing **AB15**

Scale @ A3 1:1000
Scale @ A1 1:500

Revision **A**

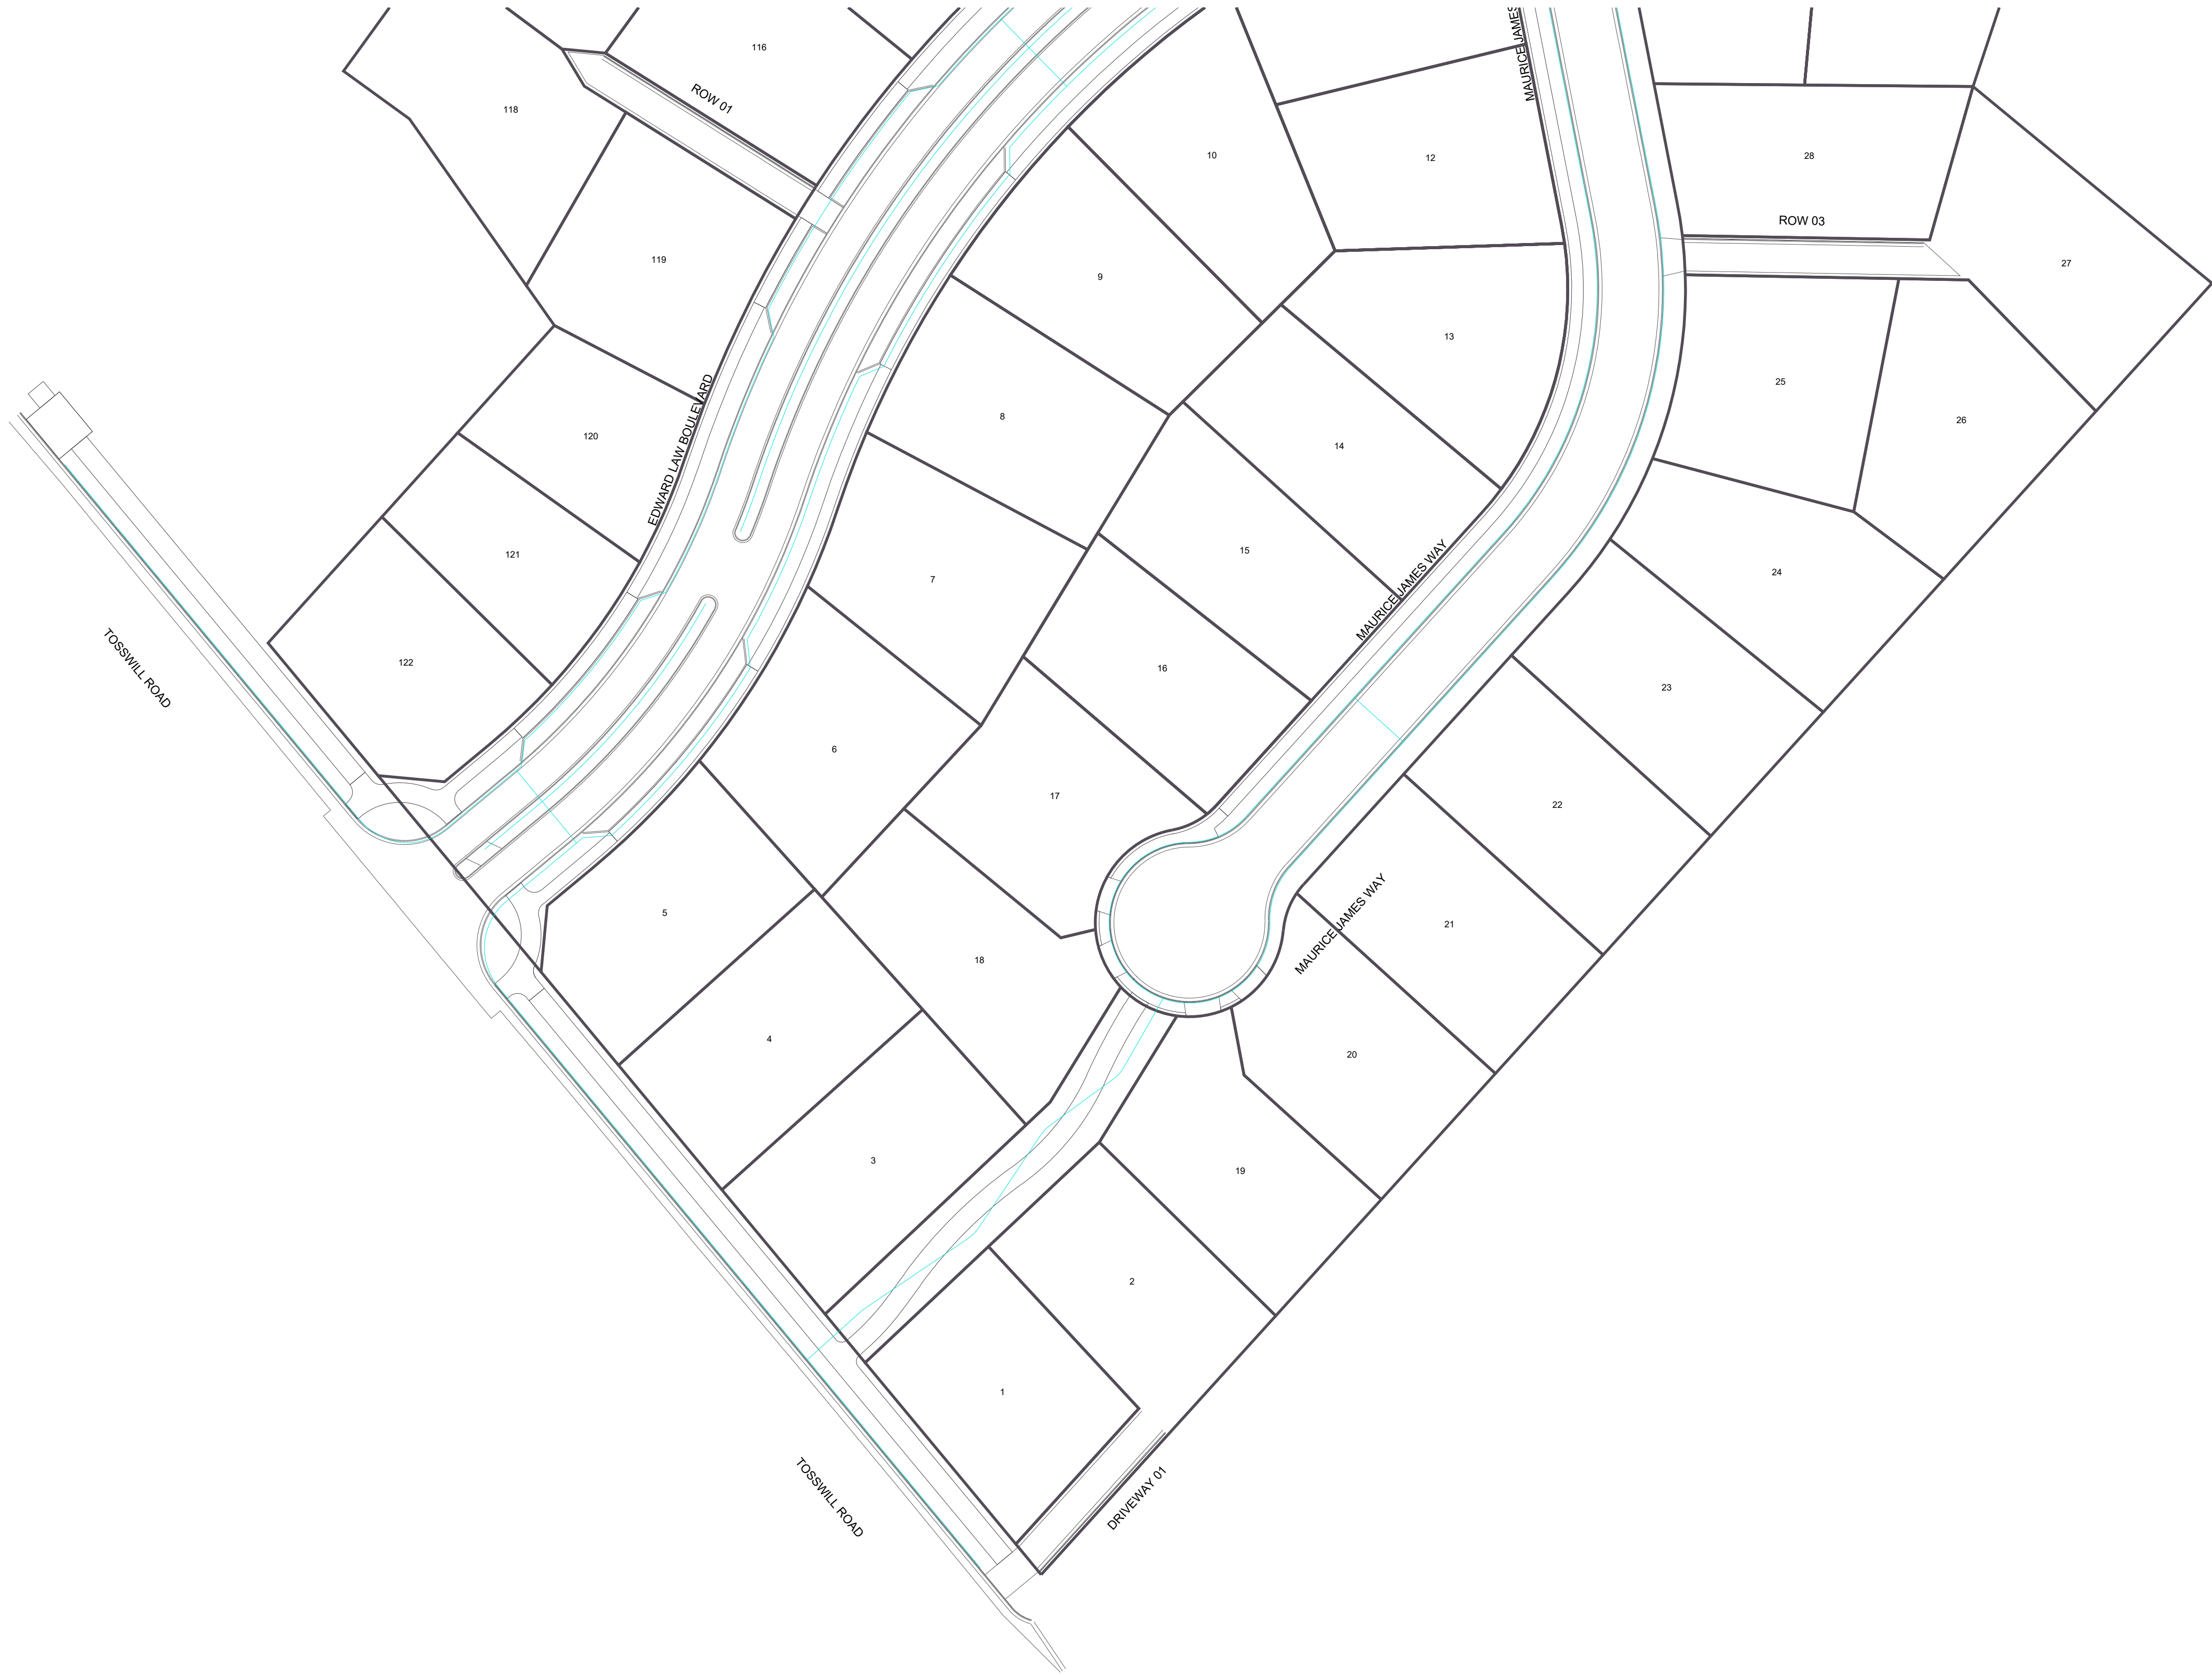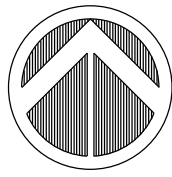

Title

**PREVELLES, PREBBLETON
IRRIGATION ASBUILTS**

Origin of Levels - BM EK06, Capped SS, Cnr Halswell Junction Rd and Springs Rd. RL 23.311
Level Datum - Lyttelton 1937

Drawn	SM	Date	03/03/21
		QA check	CP

A	03/03/21	224 Application	CP
issue	date	reason	approved

AutoCAD ref: 195533-ASBUILTS
Sheet .

Drawing **AB16**

Scale @ A3 1:1000
Scale @ A1 1:500

Revision **A**

LEGEND

DN32 PE irrigation