


/ issue	/ date	/ reason	/ approved
ABI	8/07/22	Asbuilt Plans	

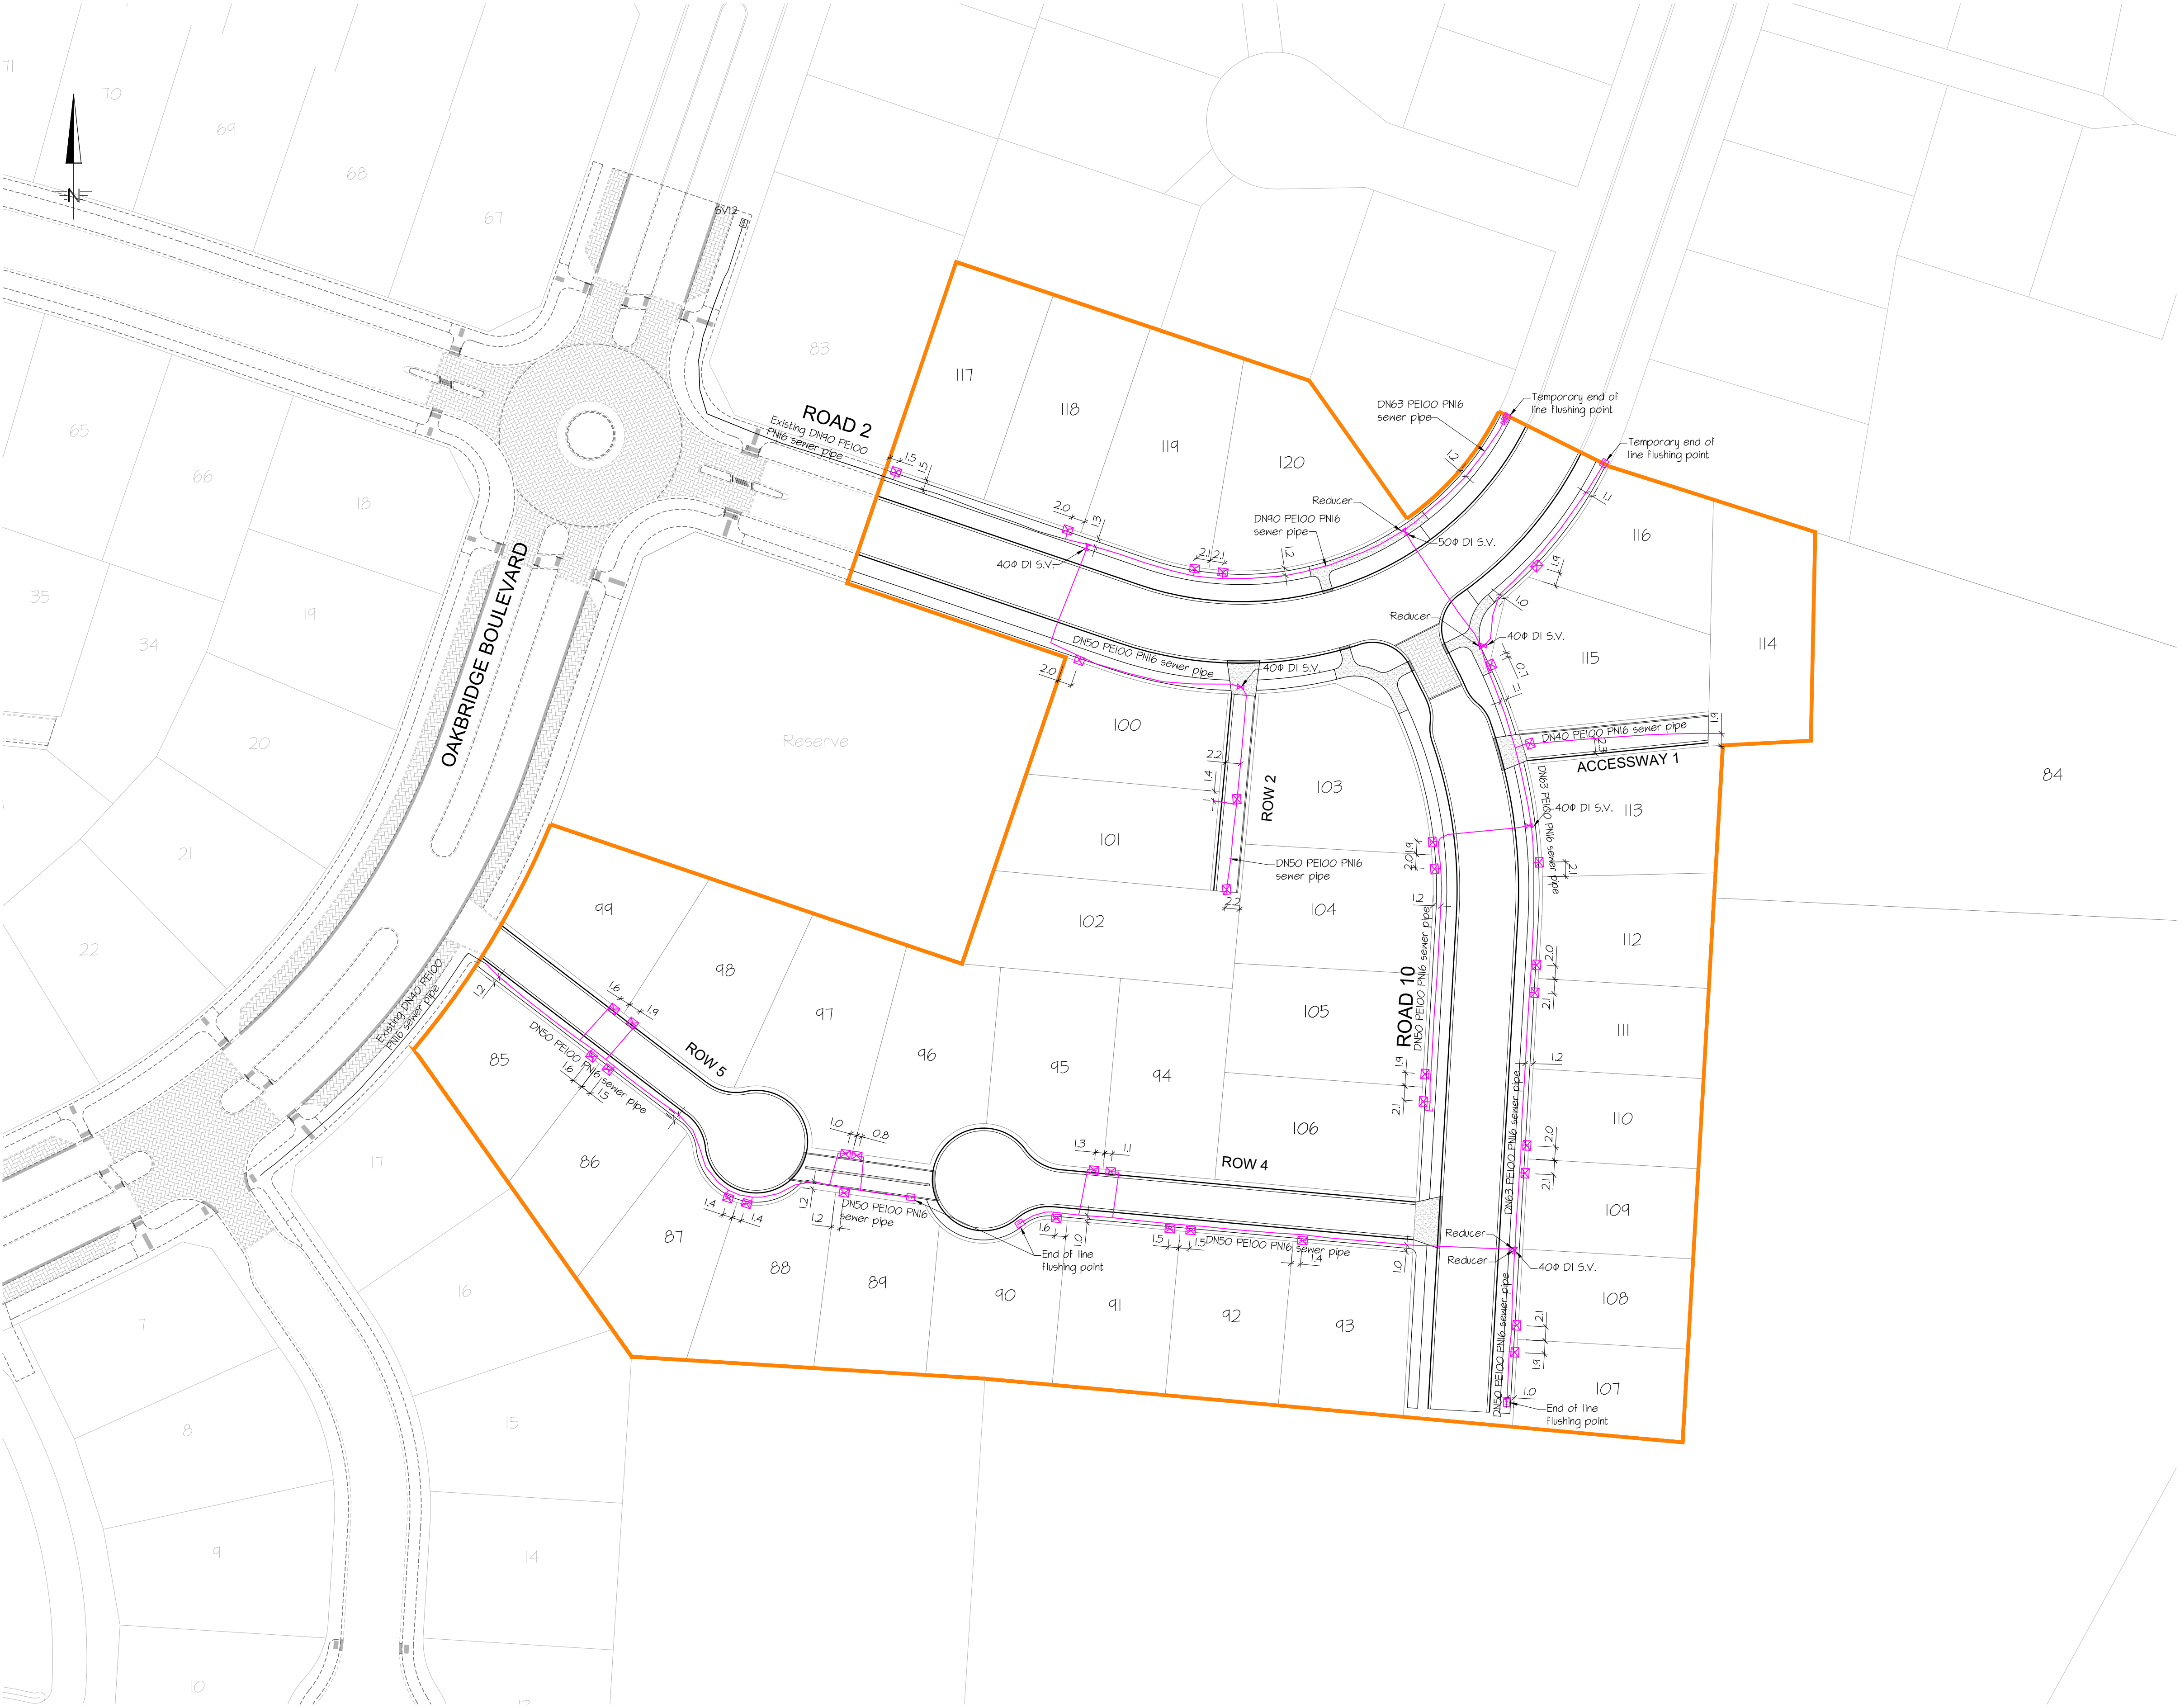

CAD ref: 34300.Stage2 Asbuilts.dwg

do

DAVIS OGILVIE


ENGINEERS / SURVEYORS / PLANNERS

Davis Ogilvie & Partners Limited

Level 1, 24 Moorhouse Avenue, Addington, Christchurch 8140

Office 0800 999 333 Email hello@do.nz

www.do.nz

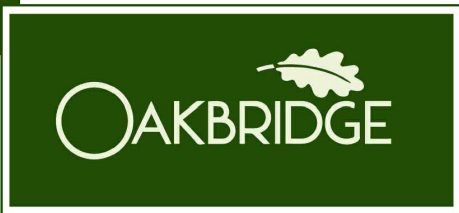


OAKBRIDGE - PRESTONS ROAD, REDWOOD
PROPOSED SUBDIVISION - RMA/2022/330

ENGINEERING ASBUILT PLAN
SEWER ASBUILT PLAN - STAGE 2

design	drawn	QA check	dwg
DGB	SM	JW	AB201
scale @ A1	date	file	issue
1:500	07/22	34300	AB1

/ issue	/ date	/ reason	/ approved
ABI	8/07/22	Asbuilt Plans	

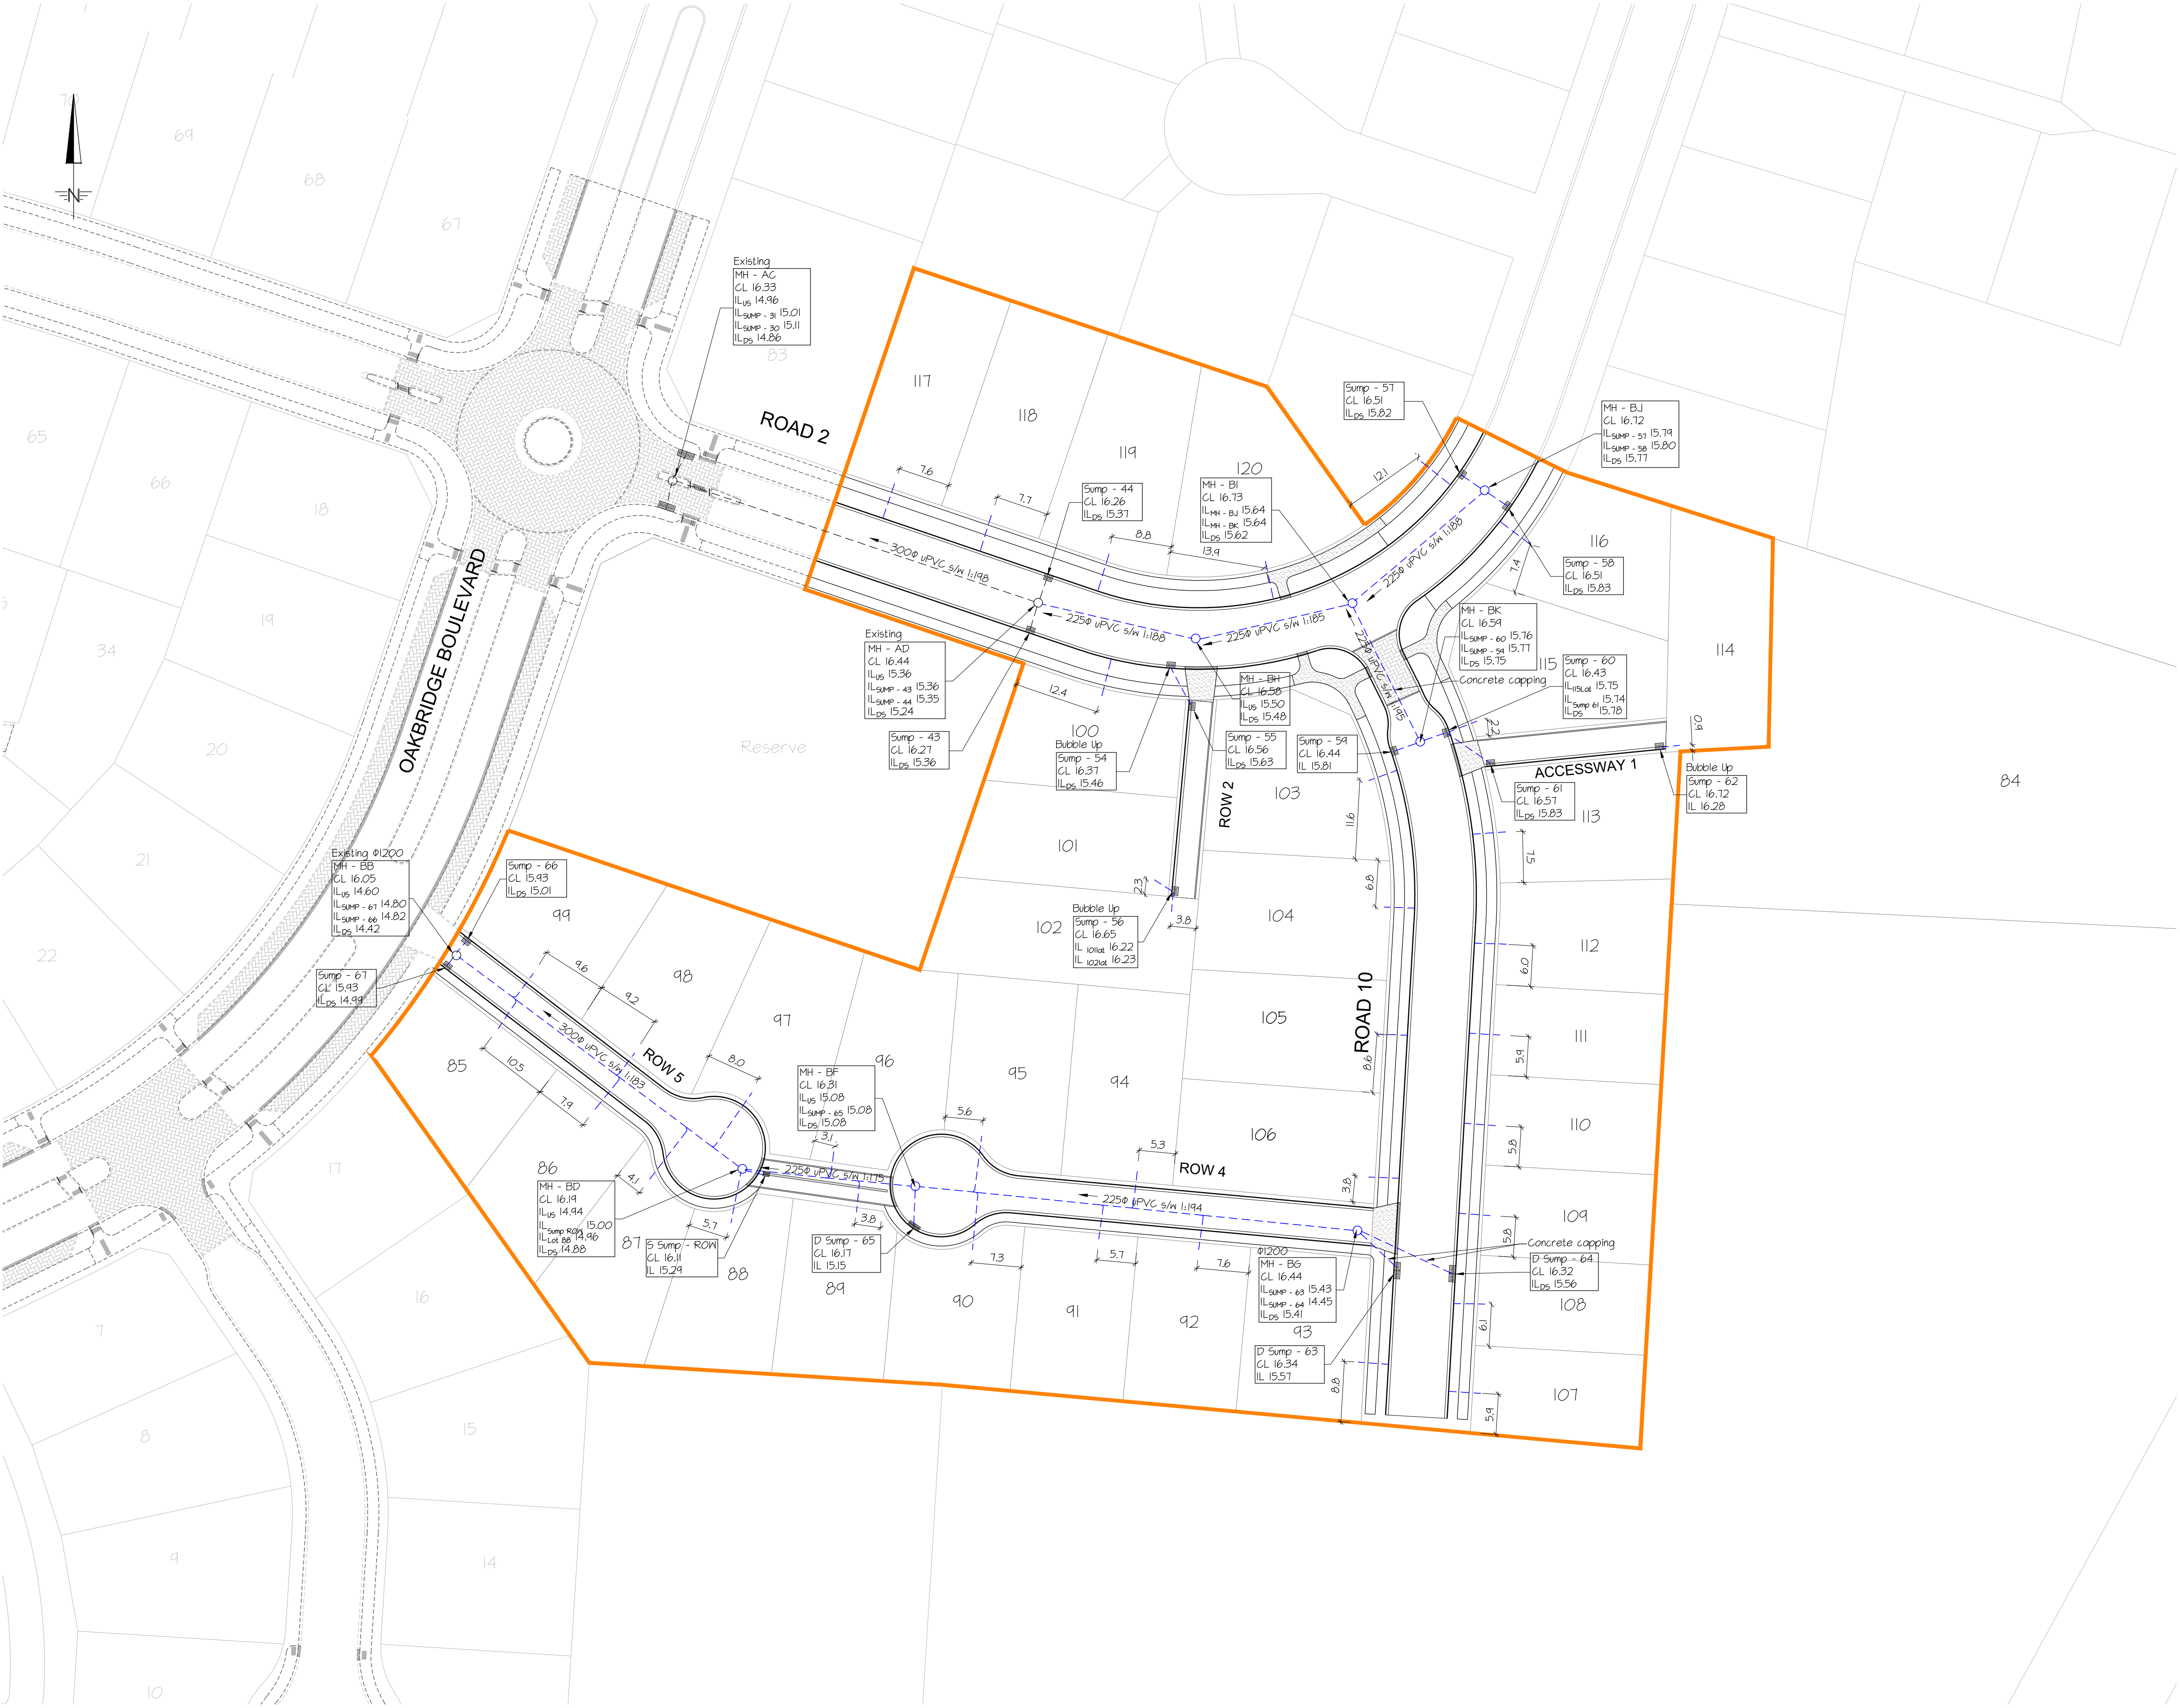

CAD ref: 34300.Stage2 Asbuilts.dwg

do

DAVIS OGILVIE


ENGINEERS / SURVEYORS / PLANNERS

Davis Ogilvie & Partners Limited

Level 1, 24 Moorhouse Avenue, Addington, Christchurch 8140

Office 0800 999 333 Email hello@do.nz

www.do.nz

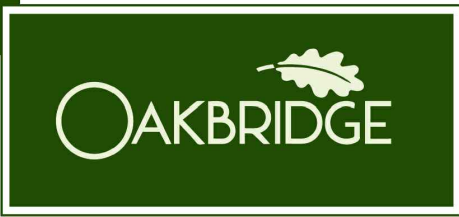


OAKBRIDGE - PRESTONS ROAD, REDWOOD
PROPOSED SUBDIVISION - RMA/2022/330

ENGINEERING ASBUILT PLAN
STORMWATER ASBUILT PLAN - STAGE 2

design	drawn	QA check	dwg
DGB	SM	JW	AB202
scale @ A1	date	file	issue
1:500	07/22	34300	AB1

/ issue	/ date	/ reason	/ approved
ABI	8/07/22	Asbuilt Plans	

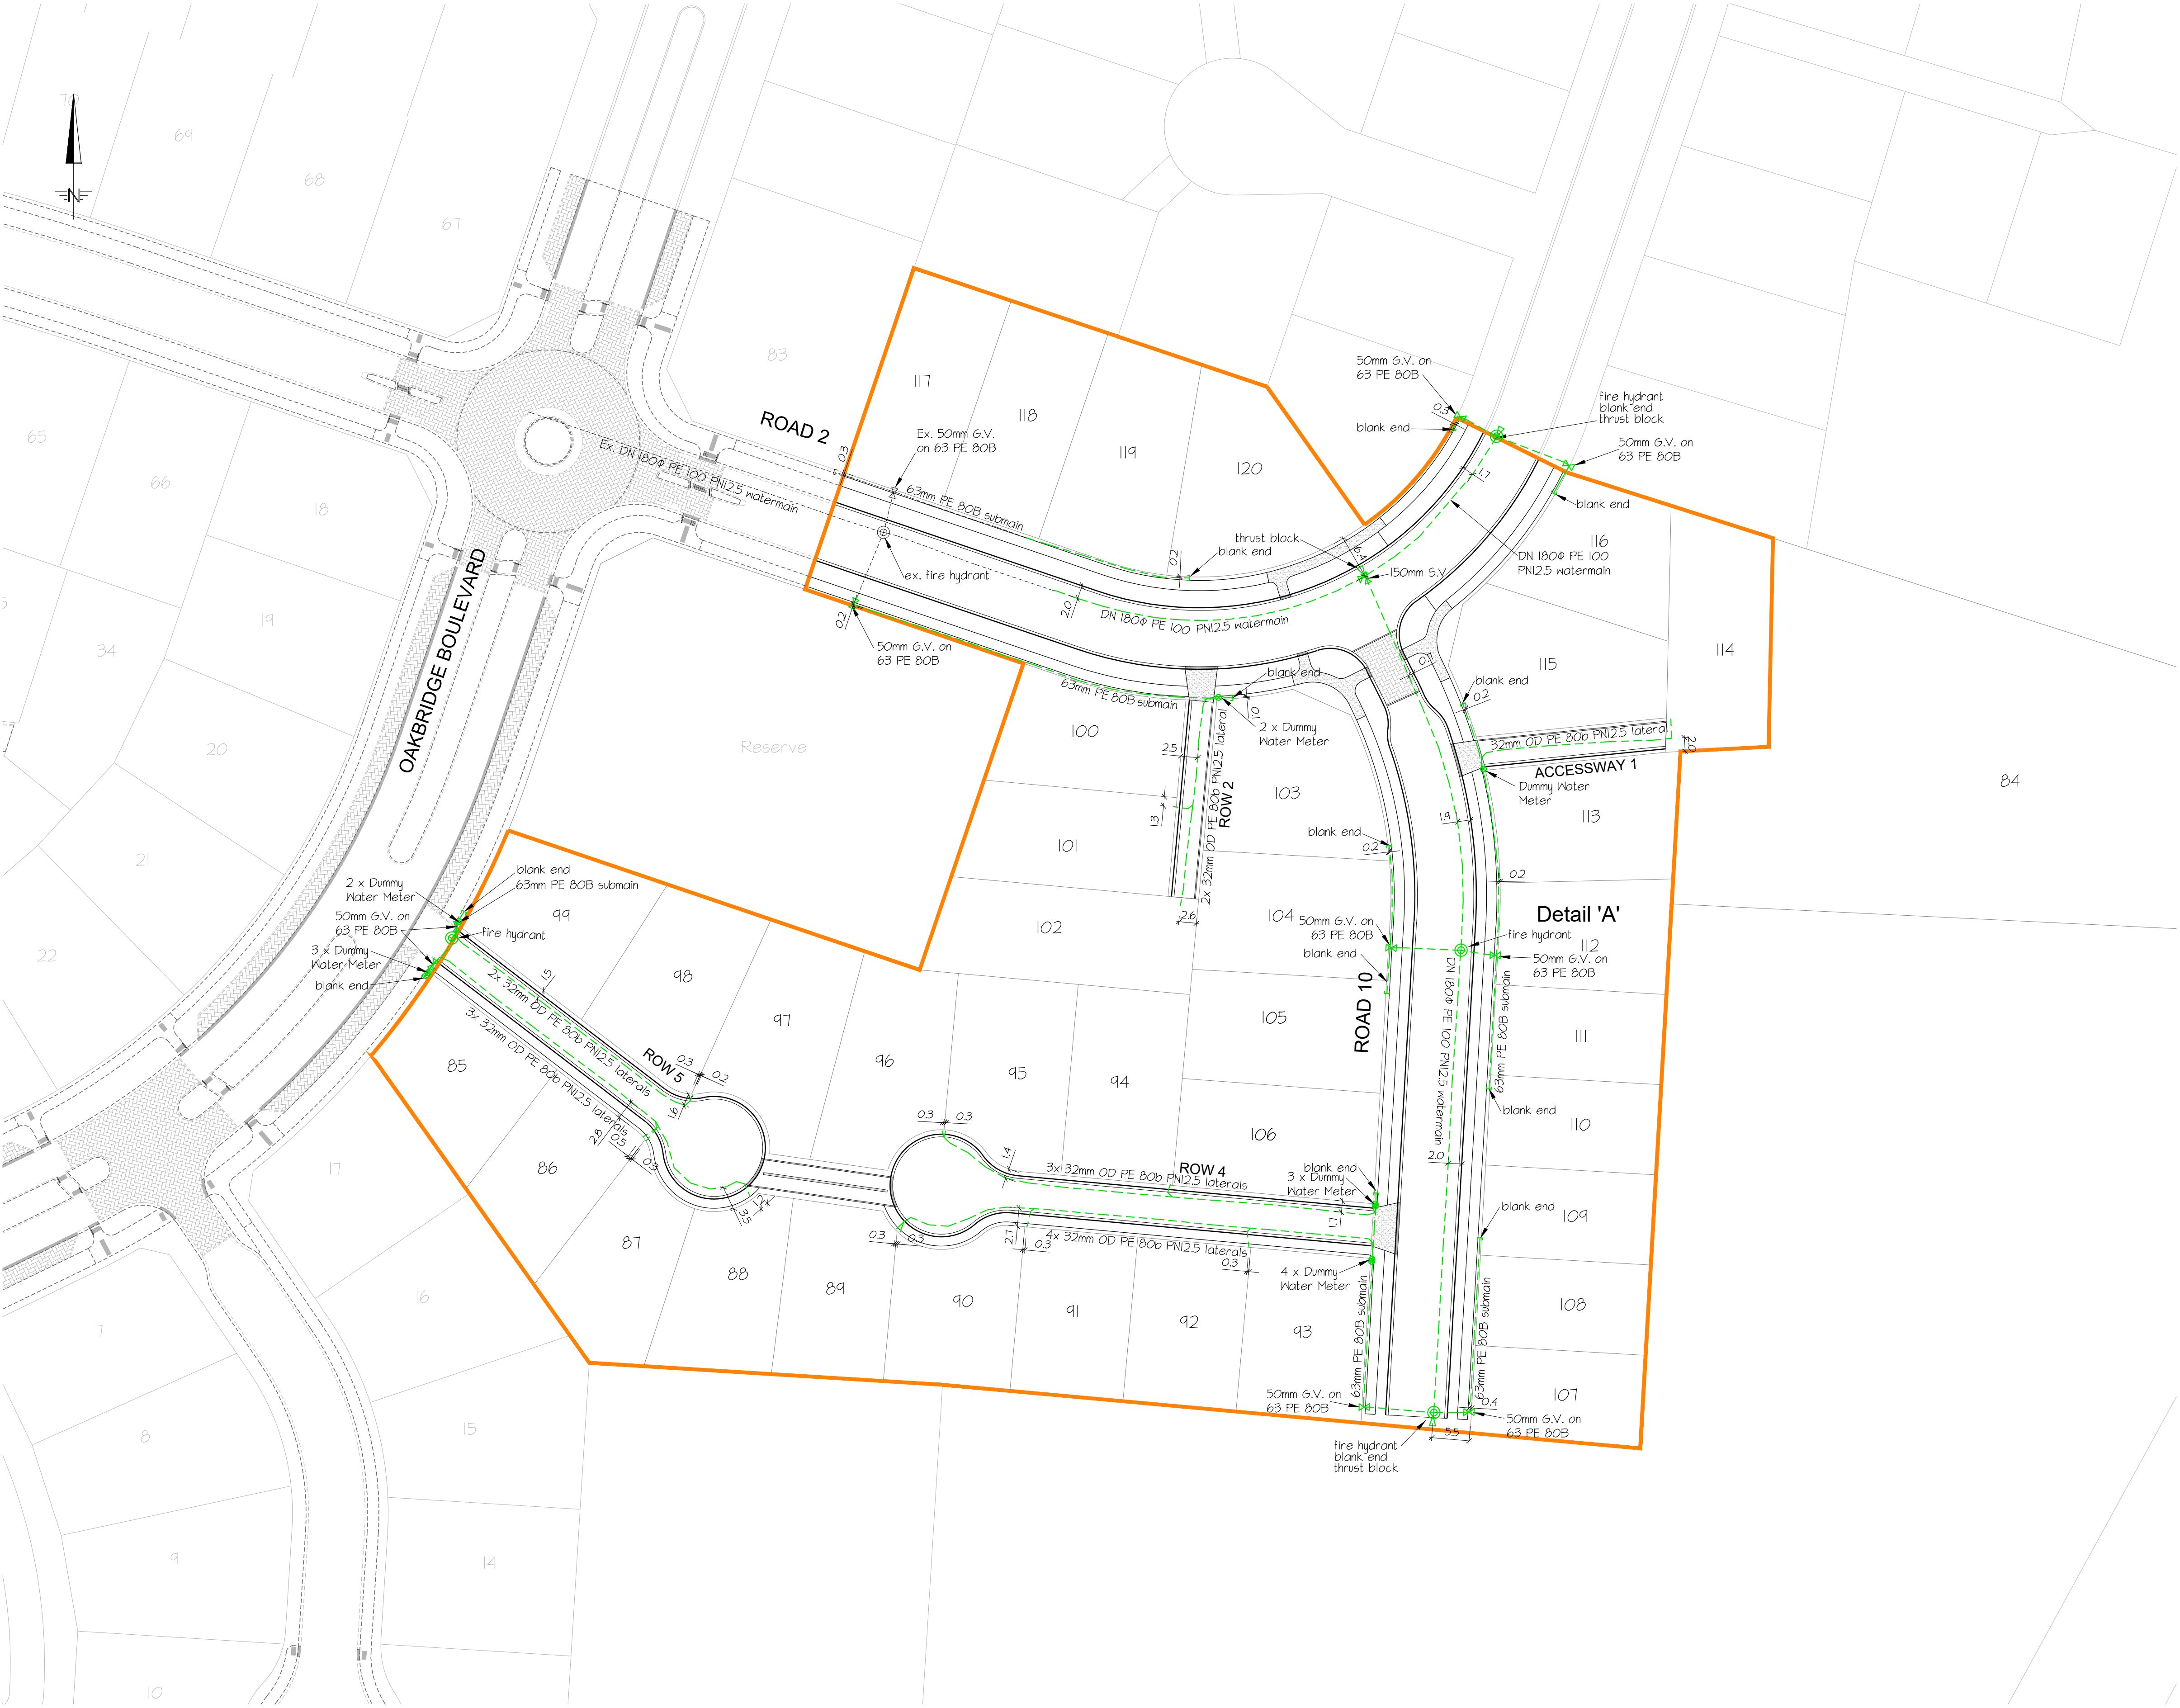

CAD ref: 34300.Stage2 Asbuilts.dwg

do

DAVIS OGILVIE


ENGINEERS / SURVEYORS / PLANNERS

David Ogilvie & Partners Limited

Level 1, 24 Moorhouse Avenue, Addington, Christchurch 8140

Office 0800 999 333 Email hello@do.nz

www.do.nz

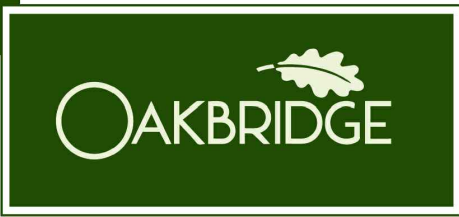

OAKBRIDGE - PRESTONS ROAD, REDWOOD
PROPOSED SUBDIVISION - RMA/2022/330

ENGINEERING ASBUILT PLAN
WATER ASBUILT PLAN - STAGE 2

design DGB	drawn SM	QA check JW	dwg AB203
scale @ A1 1:500	date 07/22	file 34300	issue AB1